


State Water Control Board
P. O. Box 11143
2111 North Hamilton St.
Richmond, Va. 23230

(Certification of Completion/County Permit)

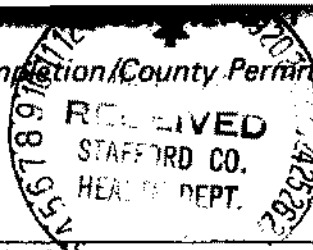

BWCM No. _____

County/City _____

County/City Stamp _____

SWCB Permit _____
County Permit Stafford
Certification of inspecting official:
This well does _____ does not
meet code/low requirements.
S. _____
Date _____
For Office Use

• Virginia Plane Coordinates
N _____
E _____
Latitude & Longitude
N _____
W _____
• Topo. Map No. _____
• Elevation _____ ft.
• Formation _____
• Lithology _____
• River Basin _____
• Province _____
• Type Logs _____
• Cuttings _____
• Water Analysis _____
• Aquifer Test _____

• Owner Stone Bros., Inc. - Leonard F. Tolson
• Well Designation or Number _____
Address Rt. 2, Box 1233
Stafford, Va. 22554
Phone 752-4646
DOMINION WELL COMPANY
• Drilling Contractor 361-3443-Manassas 777-3727-Leesburg
Address 361-9126-Manassas 825-2330-Culpeper
631-0266-Metro 672-3320-Orange
Phone 347-3342-Warrenton 371-7766-Fredericksburg

SD 83-253
Tax Map I.D. No. 8B G 19W
Subdivision Lake Arrowhead
Section XXX G
Block _____
Lot 19W
Class Well: I _____, IIA _____
IIB X, IIIA _____, IIIB _____
IIIC _____, IIID _____, IIIE _____

WELL LOCATION: _____ (feet/miles _____ direction) of
and _____ feet/miles _____ (direction) of
(If possible please include map showing location marked) Directions: See Reverse

Date started 5/3/84 • Date completed 5/8/84 Type rig air rotary

I. WELL DATA: New X Reworked _____ Deepened _____
• Total depth 227 ft.
• Depth to bedrock 52 ft.
• Hole size (Also include reamed zones)
• 10 inches from 0 to 62 ft.
• 6 1/8 inches from 62 to 227 ft.
• _____ inches from _____ to _____ ft.
• Casing size (I.D.) and material
• 6 5/8 inches from 0 to 63 ft.
Material steel
Wt. per foot 13 or wall thickness .188 in.
• _____ inches from _____ to _____ ft.
Material _____
Wt. per foot _____ or wall thickness _____ in.
• _____ inches from _____ to _____ ft.
Material _____
Wt. per foot _____ or wall thickness _____ in.
• Screen size and mesh for each zone (where applicable)
• _____ inches from _____ to _____ ft.
• Mesh size _____ Type _____
• _____ inches from _____ to _____ ft.
• Mesh size _____ Type _____
• _____ inches from _____ to _____ ft.
• Mesh size _____ Type _____
• _____ inches from _____ to _____ ft.
• Mesh size _____ Type _____
• Gravel pack
• From _____ to _____ ft.
• From _____ to _____ ft.
• Grout
• From 0 to 50 ft., Type pressure
• From _____ to _____ ft., Type 21 bags

2. WATER DATA • Water temperature _____ of _____
• Static water level (unpumped level-measured) 50 ft.
• Stabilized measured pumping water level _____ ft.
• Stabilized yield 5 gpm after 1 hours
Natural Flow: Yes _____ No X, flow rate: _____ gpm
Comment on quality clear
3. WATER ZONES: From 170 to 172
From 209 To 211 From _____ To _____
From _____ To _____ From _____ To _____
4. USE DATA:
Type of use: Drinking X, Livestock Watering _____
Irrigation _____, Food processing _____, Household X
Manufacturing _____, Fire safety _____, Cleaning _____
Recreation _____, Aesthetic _____, Cooling or heating _____
Injection _____, Other _____
• Type of facility: Domestic X, Public water supply _____
Public institution _____, Farm _____, Industry _____
Commercial _____, Other _____
5. PUMP DATA: Type _____ • Rated H.P. _____
• Intake depth _____ • Capacity _____ at _____ head
6. WELLHEAD: Type well seal _____
Pressure tank _____ gal., Loc. _____
Sample tap _____, Measurement port _____
Well vent _____, Pressure relief valve _____
Gate valve _____, Check valve (when required) _____
Electrical disconnect switch on power supply _____
7. DISINFECTION: Well disinfected _____ yes _____ no _____
Date _____, Disinfectant used _____
Amount _____, Hours used _____
8. ABANDONMENT (where applicable) • yes _____ no _____
Casing pulled yes _____ no _____ not applicable _____
Plugging grout From _____ to _____ material _____

9. State law requires submitting to the Virginia State Water Control Board information about groundwater and wells for every well made in the State intended for water, or any other non-exempt well. This information must be submitted whether the well is completed, on standby, or abandoned. Information required includes: an accurately and completely prepared water well completion report, full data from any aquifer pumping tests, drill cuttings taken at ten foot intervals (unless exemption is secured), the results of any chemical analyses, and copies of any geophysical logs. Quarterly pumpage and use reports are required from owners of public supply and industrial wells. County or State permits to drill may be required in some parts of the state. Some counties require submission of a water well completion report. The Virginia State Health Department requires a water well completion report for public supply wells.

10. DRILLERS LOG (use additional Sheets if necessary)

DEPTH (feet)		TYPE OF ROCK OR SOIL (color, material, fossils, hardness, etc.)	REMARKS (water, caving, cavities, broken, core, shot, (etc.))	Drilling Time (Min.)
From	To			
0	52	Overburden		
52	91	Gray Schist		
91	227	Gray Granite		

12. DIAGRAM OF WELL CONSTRUCTION (with dimensions)

RT. 28 S to Rt. 806 L to Rt. 616 L to Rt. 610 L to Arrowhead Dr. R to Woodland L to Lakeview Dr. R to end "T" become Beach Dr. to Lot 19 WG on R.

13. Well lot dedicated? _____; Size _____ ft. X _____ ft.; Well house? _____
 Distance to nearest pollutant source _____ ft., Type _____
 Distance to nearest property line _____ ft., Building _____ ft.

14. WATER SERVICE PIPE: Checked under _____ p.s.i. for _____ minutes. Pipe size _____ inches, Material _____
 Installer _____
 Date _____

15. I certify that the information contained herein is true and correct and that this well and/or system has been installed and constructed in accordance with the requirements for well construction as specified in compliance with appropriate county or independent city ordinances and the laws and rules of the Commonwealth of Virginia.

State Water Control Board Regional Offices

Valley Reg. Off.
 116 North Main Street
 P. O. Box 268
 Bridgewater, Va. 22812
 703-828-2595

Piedmont Reg. Off.
 4010 West Broad Street
 P. O. Box 6616
 Richmond, Va. 23230
 804-257-1006

Southwest Reg. Off.
 408 East Main Street
 P. O. Box 476
 Abingdon, Va. 24210
 703-628-5183

Tidewater Reg. Off.
 287 Pembroke Office Park
 Suite 310 Pembroke No. 2
 Va. Beach, Va. 23462
 804-499-8742

West Central Reg. Off.
 Executive Park
 3312 Peters Creek Road
 Roanoke, Va. 24019
 703-982-7482

Northern Virginia Reg. Off.
 5515 Cherokee Avenue
 Suite 404
 Alexandria, Va. 22312
 703-750-9111

Signature J. P. Earnest (Seal), Date 5/14/84
 License No. _____