

and Homes
111 Watersedge Lane
Fredericksburg VA 22406
Day 786-1480
Night 752-0202

Commonwealth of Virginia
Uniform Water Well Completion Report

Owner Jony Sala Laurence Sala
Address 111 Watersedge Lane
Fredericksburg, VA 22406
Phone 786-1480

Tax Map ID 8-3A
VDH Permit SWP-01-141
VWCB Permit _____
VWCB ID _____

Location 555 Jackson Mill Road (on right - just after
Property of Uduvala Gernert Lot 3A Hidden Lake) Stafford County
Well Classification IIIA IIIB IIIC IV DTC
* Well Data *

General Information

Drilling Method Air Rotary
Depth to Bedrock 55
Static Water Level 430'
Well Disinfected (Y or N) _____

Date Completed 10/5/01
Yield 5 (GPM)
Stabilized Water Level 360'
Disinfectant Used _____

Total Depth of Well 400
Length of Test Approx 1 hr.
Natural Flow (Rate) _____
Amount Used _____

Casing

From 4' To 74'
Size 4" Material P.V.C.
Weight/Schedule SDR 27

From 60' To 360'
Size 4" Material P.V.C.
Weight/Schedule Sch. 40

From 380' To 400'
Size 4" Material P.V.C.
Weight/Schedule Sch. 40

Gravel Pack

From _____ To _____

From _____ To _____

From _____ To _____

Hole size

10" from 0' to 60'

7 7/8" from 60' to 74'

6 7/8" from 74' to 400'

Grout From 0' To 60'

From _____ To _____

From _____ To _____

Bore Hole Size 10"

Bore Hole Size _____

Bore Hole Size _____

Type Bentonite

Type _____

Type _____

Method Pressure Grouting

Method _____

Method _____

Water Zones or Screened Intervals

From 360' To 380'
Mesh Size 0.020 Diam 4" (P.V.C.)

From 160' To 161'
Mesh Size _____ Diam _____

From _____ To _____
Mesh Size _____ Diam _____

From _____ To _____
Mesh Size _____ Diam _____

From 370' To 371'
Mesh Size _____ Diam _____

From _____ To _____
Mesh Size _____ Diam _____

* Use Data *

Private Well: Domestic Agricultural _____ Industrial _____ Monitoring _____
Public Well: Community _____ Non Community _____

* Abandonment Information *

Bored or Dug Wells

Casing Removed, Y or N? _____
If Y, Depth to which casing was removed: _____
Depth and Type of Fill: _____
Source of Fill: _____
Bentonite Plugs: From _____ to _____ From _____ to _____

Wells other than Bored Wells

Casing removed, Y or N? _____
Depth to which casing was removed: _____
Applicable, depth(s), and type of gravel/sand fill: _____
Source of gravel or sand: _____
Cement: From _____ to _____ From _____ to _____

Method of permanently marking location: _____

Installed watertight top
Suggest setting pump @ approx. 380'

you will encounter 4" casing @ approx 60'
be sure keeping centralizers & torque arrestors out of 4" casing.

Preferred Home

Long Lake - Laurel Lake

Property of Ursula Smart (555 Tackets Mill Rd.)

Stafford

Just after entrance to Hidden Lake

Drillers Log


Depth

Description of Formation or Sediment

Remarks

0	10	Red Clay
10	150	Brown Shale
150	400	Grey Shale

set 4" P.V.C. Well Casing & Screen - as listed due to the softness of the formation

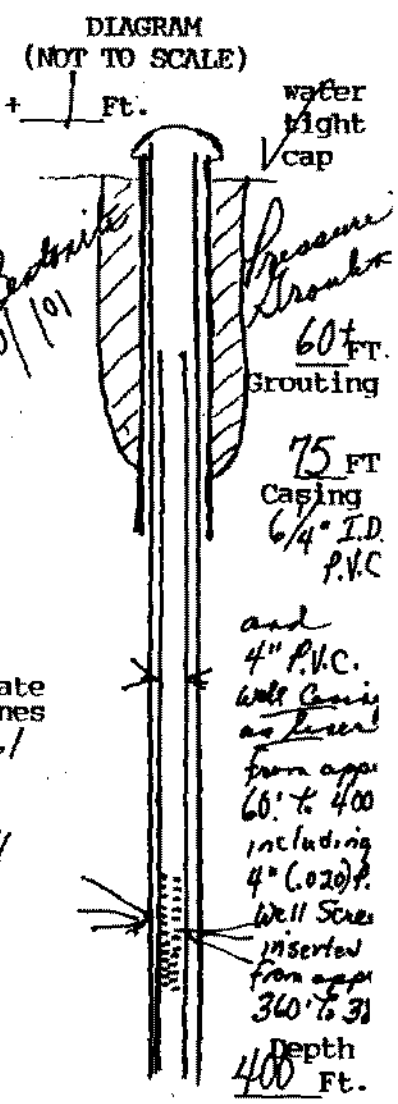

Approximate Water Zones
160 to 161
and
370 to 371

(Use additional Sheets if necessary)

I certify that the information contained here is true and that this well was installed and constructed in accordance with the permit and further that the well complies with all applicable state and local regulations, ordinances and laws.

Name JOHN L. DANIELSON, JR., INC.
 Address 1616 HOOD DRIVE
FREDERICKSBURG, VIRGINIA 22400
 Phone 540 (703) 898-6025 / 898-9355

Drillers Signature [Signature]
 Date 10/01 Representing JOHN L. DANIELSON, JR., INC.

Virginia Contractors License Number CLASS A 2701 014084A 11/11 WVC