

Commonwealth of Virginia
Uniform Water Well Completion Report

Owner Thomas Seward
 Address 119 Springhill Road
Stafford Va
 Phone 752-1544 W 703-358-6460 / 703-358-6470
 Location Millbrook #10 (Spring Hill Road)
183C Approx 3/4 M. South of Jct of 6127 Millbrook
 Well Classification IIIA IIIB IIIC IV

Tax Map ID 8-10
 VDH Permit WS-94-75
 VWCB Permit _____
 VWCB ID _____
 County Stafford
3/14/94 Adrian Wang
4/26/94 T Thompson

* Well Data *

General Information
 Drilling Method Air Rotary
 Depth to Bedrock 20'
 Static Water Level 20'
 Well Disinfected (Y or N) _____

Date Completed 8/30/94
 Yield 15 (GPM)
 Stabilized Water Level 20'
 Disinfectant Used _____

Total Depth of Well 200
 Length of Test 1 Hr.
 Natural Flow (Rate) _____
 Amount Used _____

Casing
 From 7 1/2' To 57'
 Size 6" Material P.V.C.
 Weight/Schedule SDR 27

From 50' To 160'
 Size 4" Material P.V.C.
 Weight/Schedule Sch 40

From 180' To 200'
 Size 4" Material P.V.C.
 Weight/Schedule Sch 40

Gravel Pack
 From _____ To _____
 Hole size 10" from 0 to 50ft.
 Grout From 0 To 50' 8/3/94
 Bore Hole Size 10"
 Type Bentonite
 Method Pressure Grouting

From _____ To _____
 Hole size 7 7/8" from 50 to 57ft.
 From _____ To _____
 Bore Hole Size _____
 Type _____
 Method _____

From _____ To _____
 Hole size 6 1/8" from 57 to 200ft.
 From _____ To _____
 Bore Hole Size _____
 Type _____
 Method _____

Water Zones or Screened Intervals
 From 170 To 171
 Mesh Size _____ Diam _____
 From _____ To _____
 Mesh Size _____ Diam _____

Screen
 From 160 To 180
 Mesh Size .020 Diam 4" P.V.C.
 From _____ To _____
 Mesh Size _____ Diam _____

From _____ To _____
 Mesh Size _____ Diam _____
 From _____ To _____
 Mesh Size _____ Diam _____

* Use Data *

Private Well: Domestic Agricultural _____ Industrial _____ Monitoring _____
 Public Well: Community _____ Non Community _____

* Abandonment Information *

Bored or Dug Wells
 Casing Removed, Y or N? _____
 If Y, Depth to which casing was removed: _____
 Depth and Type of Fill: _____
 Source of Fill _____
 Bentonite Plugs: From _____ to _____ From _____ to _____

Wells other than Bored Wells
 Casing removed, Y or N? _____
 Depth to which casing was removed _____
 Applicable, depth(s), and type of gravel/sand fill: _____
 Source of gravel or sand: _____
 Cement: From _____ to _____ From _____ to _____

Method of permanently marking location:
 Installed watertight top
 Suggest setting pump @ approx. 155 ft.
You will encounter 4" casing @ approx 50 Ft.
Suggest keeping torque abreactors & centralizers
out of 4" casing.

Thomas Seward
Mellbrook #10
Springhill Road
Stafford
 off #612


* Drillers Log *

Department of Virginia
 State Department of Health

Depth Description of Formation or Sediment Remarks

0	10	Red Clay	
10	30	Micaceous formation/Red	
30	40	Micaceous formation/Brown	
40	57	Brown Shale	set 4" P.V.C. & Screen due to the softness of the formation
57	200	Blue Shale	

DIAGRAM
 (NOT TO SCALE)

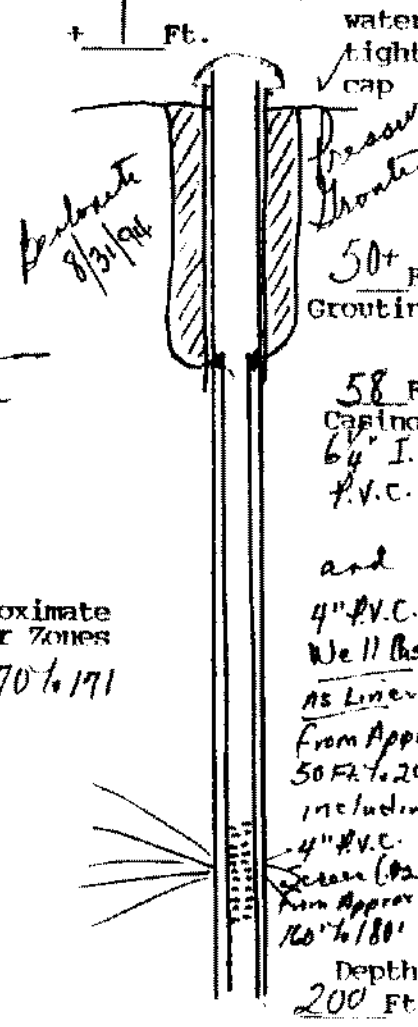

Permit
 8/31/94



Approximate
 Water Zones
 170' to 171'

(Use additional Sheets if necessary)

I certify that the information contained here is true and that this well was installed and constructed in accordance with the permit and further that the well complies with all applicable state and local regulations, ordinances and laws

Name JOHN L. DANIELSON, JR., INC.
 Address 4616 HOOD DRIVE
FREDERICKSBURG, VIRGINIA 22408
 Phone (703) 898-6025 / 898-9355

Drillers Signature John L. Danielson, Jr.
 Date 8/31/94 Representing JOHN L. DANIELSON, JR., INC.

Virginia Contractors License Number CLASS A 2701 014084A 11/11 WMC