

State Water Control Board
P. O. Box 11143
2111 North Hamilton St.
Richmond, Va. 23230

(Certification of Completion/County Permit)

Crown Construction Company
Post P. O. Box 81st
Stafford, Va 22554
659-7878
County/City Stamp *690-8465*

County/City *Stafford*

SWCB Permit _____
County Permit _____
Certification of inspecting official:
This well does _____ does not
meet code/low requirements.
S. _____
Date _____

• Virginia Plane Coordinates
N _____
E _____
Latitude & Longitude
N _____
W _____
• Topo. Map No. *183A*
• Elevation _____ ft.
• Formation _____
• Lithology _____
• River Basin _____
• Province _____
• Type Logs *D. L.*
• Cuttings *N. A.*
• Water Analysis _____
• Aquifer Test _____

• Owner _____
• Well Designation or Number _____
Address _____
Phone _____
• Drilling Contractor *John L. Danielson, Jr., Inc.*
Address *4616 Hood Drive*
Fredericksburg, Virginia 22401
Phone *(703) 898-6025*

For Office Use
189-84-391 11/30/89
Robert S.
Tax Map I.D. No. *9-3-4*
Subdivision *Stafford Station*
Section _____
Block _____
Lot _____
Class Well I _____ IIA _____
IIB IIIA _____ IIIB _____
IIIC _____ IIID _____ IIIE _____

WELL LOCATION: (feet/miles _____ direction) of _____
and _____ feet/miles (direction) of _____
(If possible please include map showing location marked) *3/4 Miles N of 610 & Timothy Lane*
Date started *4/14/90* • Date completed *4/16/90* Type rig *Air Rotary*

WELL DATA: New _____ Reworked _____ Deepened _____
• Total depth _____ *260* ft.
• Depth to bedrock _____ *94* ft.
• Hole size (Also include reamed zones)
• *10* inches from _____ *0* to _____ *94* ft.
• *6 3/4* inches from _____ *94* to _____ *260* ft.
• _____ inches from _____ to _____ ft.
• Casing size (I.D.) and material
• *6 3/4* inches from _____ *+1* to _____ *94* ft.
Material *PVC*
Wt. per foot _____ or wall thickness *SDR 27* in.
• _____ inches from _____ to _____ ft.
Material _____
Wt. per foot _____ or wall thickness _____ in.
• _____ inches from _____ to _____ ft.
Material _____
Wt. per foot _____ or wall thickness _____ in.
• Screen size and mesh for each zone (where applicable)
• _____ inches from _____ to _____ ft.
• Mesh size _____ Type _____
• _____ inches from _____ to _____ ft.
• Mesh size _____ Type _____
• _____ inches from _____ to _____ ft.
• Mesh size _____ Type _____
• _____ inches from _____ to _____ ft.
• Mesh size _____ Type _____
• Gravel pack
• From _____ to _____ ft.
• From _____ to _____ ft.
• Grout
• From *0* to *50* ft. Type *Neat Cement*
• From _____ to _____ ft. Type _____

Approximate Drawdown *150* feet.
2. WATER DATA • Water temperature _____ of _____
• Static water level (unpumped level-measured) _____ ft.
• Stabilized measured pumping water level _____ ft.
• Stabilized yield *5* gpm after _____ hour
Natural Flow Yes _____ No Flow rate _____ g pm
Comment on quality _____

3. WATER ZONES: From *246* To *247*
From _____ To _____ From _____ To _____
From _____ To _____ From _____ To _____

4. USE DATA:
Type of use: Drinking Livestock Watering _____
Irrigation _____ Food processing _____ Household
Manufacturing _____ Fire safety _____ Cleaning _____
Recreation _____ Aesthetic _____ Cooling or heating _____
Injection _____ Other _____
• Type of facility: Domestic Public water supply _____
Public institution _____ Farm _____ Industry _____
Commercial _____ Other _____

5. PUMP DATA: Type _____ Rated H.P. _____
• Intake depth _____ Capacity _____ at _____ head

6. WELLHEAD: Type well seal _____
Pressure tank _____ gal., Loc. _____
Sample tap _____ Measurement port _____
Well vent _____ Pressure relief valve _____
Gate valve _____ Check valve (when required) _____
Electrical disconnect switch on power supply _____

7. DISINFECTION: Well disinfected _____ yes _____ no _____
Date _____ Disinfectant used _____
Amount _____ Hours used _____

8. ABANDONMENT (where applicable) • yes _____ no _____
Casing pulled yes _____ no _____ not applicable _____
Plugging grout From _____ to _____ material _____
Pump installed through _____

Pressure installed 4/18/90
Installed Waterlight Cap
Suggest setting pump @ approx 240

9. State law requires submitting to the Virginia State Water Control Board information about groundwater and wells for every well made in the State intended for water, or any other non-exempt well. This information must be submitted whether the well is completed, on standby, or abandoned. Information required includes: an accurately and completely prepared water well completion report, full data from any aquifer pumping tests, drill cuttings taken at ten foot intervals (unless exemption is assured), the results of any chemical analyses, and copies of any geophysical logs. Quarterly pumpage and use reports are required from owners of public supply and industrial wells. County or State permits to drill may be required in some parts of the state. Some counties require submission of a water well completion report. The Virginia State Health Department requires a water well completion report for public supply wells

10. DRILLERS LOG (use additional Sheets if necessary)

DEPTH (feet)		TYPE OF ROCK OR SOIL (color, material, fossils, hardness, etc.)	REMARKS (water, casing, cavities, broken, core, shot, etc.)
From	To		
0	10	red clay	
10	50	Micaceous formation/red	
50	80	Micaceous formation/Brown	
80	94	soft brown shale	
94	260	hard blue rock	


Approximate
Water Zones

246 to 247

11.

Drilling
Time
(min.)

12. DIAGRAM OF WELL CONSTRUCTION (with dimensions)

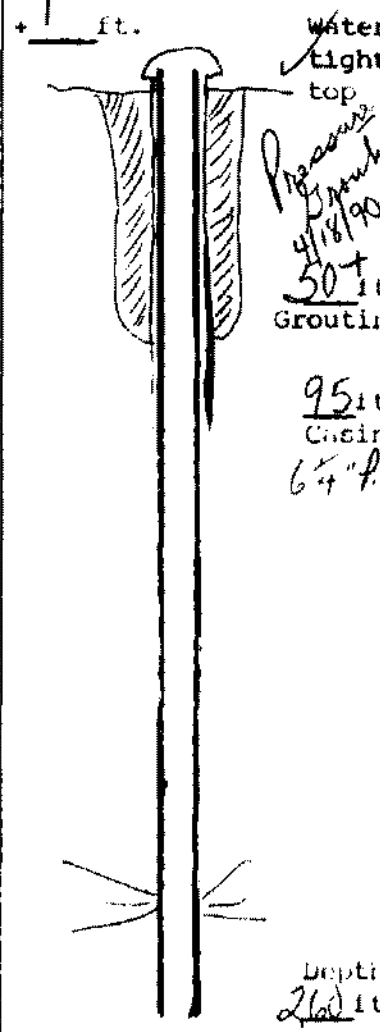

13. Well lot dedicated? _____; Size _____ ft. X _____ ft.; Well house? _____
 Distance to nearest pollutant source _____ ft., Type _____
 Distance to nearest property line _____ ft., Building _____ ft.

14. WATER SERVICE PIPE: Checked under _____ p.s.i. for _____ minutes. Pipe size _____ inches, Material _____
 Installer _____
 Date _____

State Water Control Board Regional Offices

Valley Reg. Off.
116 North Main Street
P. O. Box 268
Bridgewater, Va. 22812
703-828-2595

Piedmont Reg. Off.
4010 West Broad Street
P. O. Box 6616
Richmond, Va. 23230
804-257-1006

Southwest Reg. Off.
408 East Main Street
P. O. Box 476
Abingdon, Va. 24210
703-628-5183

Tidewater Reg. Off.
287 Pembroke Office Park
Suite 310 Pembroke No. 2
Va. Beach, Va. 23462
804-499-8742

West Central Reg. Off.
Executive Park
5312 Peters Creek Road
Roanoke, Va. 24019
703-862-7432

Northern Virginia Reg. Off.
5515 Cherokee Avenue
Suite 404
Alexandria, Va. 22312
703-750-9111

15. I certify that the information contained herein is true and correct and that this well and/or system has been installed and constructed in accordance with the requirements for well construction as specified in compliance with appropriate county or independent city ordinances and the laws and rules of the Commonwealth of Virginia.

Signature Anna T. Daniels (Well driller or authorized person) Date 4/18/90
 License No. _____