

2163 Jefferson Davis Highway
Stafford, Va. 22554
659-1063


County/City Stafford

County/City Stafford

SWCB Permit
County Permit
Certification of inspecting official:
This well does _____ does not
meet code/low requirements.
S. _____
Date _____
For Office Use

Virginia Plane Coordinates
N _____
E _____
Latitude & Longitude _____
N _____
W _____
Topo. Map No. 183A
Elevation _____ ft.
Formation _____
Lithology _____
River Basin _____
Province _____
Type Logs D. L.
Cuttings N. n.
Water Analysis _____
Aquifer Test _____

Owner For Sale
Well Designation or Number _____
Address _____
Phone _____
Drilling Contractor John L. Danielson, Inc.
Address 4616 Hood Drive
Fredericksburg, Virginia 22401
Phone (703) 898-6025

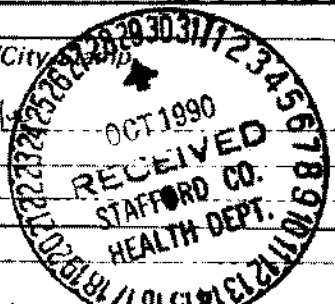

Tax Map I.D. No. 9-9E-1
Subdivision Green Acres
Section _____
Block _____
Lot 9E (1)
Class Well I _____ IIA _____
IIB _____ IIIA _____ IIIB _____
IIIC _____ IIID _____ IIIE _____

WELL LOCATION: _____ (feet/miles) (direction) of _____
and _____ (feet/miles) (direction) of _____
(If possible please include map showing location marked) 1/2 mile S of Intersection of 6102 Baker Rd

Date started 9/21/90 Date completed 9/24/90 Type rig Air Rotary
Approximate drawdown 70 feet.

WELL DATA: New Reworked _____ Deepened _____
Total depth _____ ft. 200
Depth to bedrock _____ ft.
Hole size (Also include reamed zones)
• 10 inches from 0 to 76 ft.
• 6.8 inches from 76 to 200 ft.
Casing size (I.D.) and material
• 6.4 inches from 71 to 76 ft.
Material PVC Well Casing
Wt. per foot _____ or wall thickness SDR 27 in.
Screen size and mesh for each zone (where applicable)
• _____ inches from _____ to _____ ft.
• Mesh size _____ Type _____
• _____ inches from _____ to _____ ft.
• Mesh size _____ Type _____
• _____ inches from _____ to _____ ft.
• Mesh size _____ Type _____
Gravel pack
• From _____ to _____ ft.
• From _____ to _____ ft.
Grout
• From 0 to 50 ft. Type Neat Cement
• From _____ to _____ ft. Type _____

2. WATER DATA • Water temperature _____
• Static water level (unpumped level measured) 70
• Stabilized measured pumping water level 160
• Stabilized yield 10 gpm after _____
Natural Flow: Yes _____ No flow rate _____
Comment on quality _____

3. WATER ZONES: From 186 To 187
From _____ To _____ From _____ To _____
From _____ To _____ From _____ To _____

4. USE DATA:
Type of use Drinking Livestock Watering _____
Irrigation _____ Food processing _____ Household
Manufacturing _____ Fire safety _____ Cleaning _____
Recreation _____ Aesthetic _____ Cooling or heating _____
Injection _____ Other _____
Type of facility Domestic Public water supply _____
Public institution _____ Farm _____ Industry _____
Commercial _____ Other _____

5. PUMP DATA: Type _____ Rated H.P. _____
Intake depth _____ Capacity _____ at _____ head _____

6. WELLHEAD: Type well seal _____
Pressure tank _____ gal., Loc. _____
Sample tap _____ Measurement port _____
Well vent _____ Pressure relief valve _____
Gate valve _____ Check valve (when required) _____
Electrical disconnect switch on power supply _____

7. DISINFECTION: Well disinfected _____ yes _____ no _____
Date _____ Disinfectant used _____
Amount _____ Hours used _____

8. ABANDONMENT (where applicable) • yes _____ no _____
Casing pulled yes _____ no _____ not applicable _____
Plugging grout From _____ to _____ material _____
Pump installed through _____

Pressure Grouting
Installed Waterlight Top
Support setting pump @ approx 180'
10/5/90
(6 Bags)
OVER

State Water Control Board information about groundwater and wells for every well made in the State and for any other non-exempt well. This information must be submitted whether the well is completed, on standby, or abandoned. The State Water Control Board requires submission of a water well completion report. The Virginia State Health Department requires a water well completion report for public supply wells.

10. DRILLERS LOG (use additional Sheets if necessary)

11.


Net 12. DIAGRAM OF WELL CONSTRUCTION (with dimensions)

DEPTH (feet)		TYPE OF ROCK OR SOIL (color, material, fossils, hardness, etc.)	REMARKS (water, caving, cavities, broken, core, shot, (etc.))
From	To		
0	10	Red clay	
10	40	Micaceous formation/red	
40	70	Micaceous formation/Brown	
70	76	soft Brown rock	
76	200	Hard Blue rock	

Drilling Time (Min.)

+ 1 ft.

Wat tig top

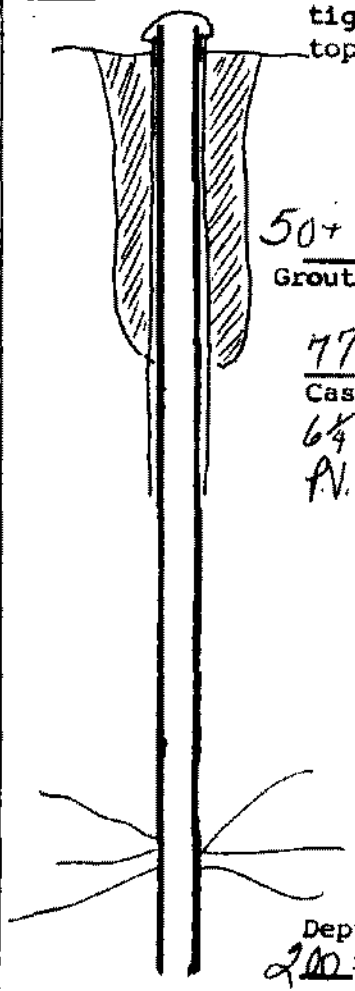

Approximate Water Zones

186 to 187

Dep 200

13. Well lot dedicated? _____; Size _____ ft. X _____ ft.; Well house? _____
 Distance to nearest pollutant source _____ ft., Type _____
 Distance to nearest property line _____ ft., Building _____ ft.

14. WATER SERVICE PIPE: Checked under _____ p.s.i. for _____
 minutes. Pipe size _____ inches, Material _____
 Installer _____
 Date _____

15. I certify that the information contained herein is true and correct and that this well and/or system has been installed and constructed in accordance with the requirements for well construction as specified in compliance with appropriate county or independent city ordinances and the laws and rules of the Commonwealth of Virginia.

Signature Anna T. Daniels (Seal), Date 10/5/90
 (Well driller or authorized person) License No. _____

State Water Control Board Regional Offices

Valley Reg. Off.
 116 North Main Street
 P. O. Box 268
 Bridgewater, Va. 22812
 703-828-2595

Piedmont Reg. Off.
 4010 West Broad Street
 P. O. Box 6616
 Richmond, Va. 23230
 804-257-1006

Southwest Reg. Off.
 408 East Main Street
 P. O. Box 476
 Abingdon, Va. 24210
 703-628-5183

Tidewater Reg. Off.
 287 Pembroke Office Park
 Suite 310 Pembroke No. 2
 Va. Beach, Va. 23462
 804-499-8742

West Central Reg. Off.
 Executive Park
 5312 Peters Creek Road
 Roanoke, Va. 24019
 703-982-7452

Northern Virginia Reg. Off.
 5515 Cherokee Avenue
 Suite 404
 Alexandria, Va. 22312
 703-750-9111