

Carl Jackson

Commonwealth of Virginia
Uniform Water Well Completion Report

Owner Break-Income Carl Jackson
Address 2231 Barronsville Rd
Stafford, Va. 22554
Phone _____
Location Arrowhead Drive/off #610
1837B
Well Classification IIIA IIIB IIIC IV
approx 1 Mile West of State 610/644 * Well Data *
" 200' South of #610

PWS ID 6179140
Tax Map ID 9XK 9-15
VDH Permit NCW-96-363
VWCB Permit _____
VWCB ID ..
County STAFFORD
10/18/96 Daniel Passalun
DJC

General Information
Drilling Method Air Rotary
Depth to Bedrock 65
Static Water Level 30
Well Disinfected (Y or N) _____

Date Completed 11/6/96
Yield 5 (GPM) by air
Stabilized Water Level _____
Disinfectant Used _____

Total Depth of Well 300
Length of Test approx 1 Hr.
Natural Flow (Rate) _____
Amount Used _____

Casing
From 71 To 79
Size 6 Material Galv. Steel
Weight/Schedule 280/Standard

From _____ To _____
Size _____ Material _____
Weight/Schedule _____

From _____ To _____
Size _____ Material _____
Weight/Schedule _____

Gravel Pack
From _____ To _____
Hole size 12" from 0 to 70ft.
Grout
From 0 To 65'
Bore Hole Size 12" 4/9/96
Type Cement
Method Pressure Grouting
40 Bags Cement

From _____ To _____
Hole size 7 7/8" from 70 to 77ft.
Grout
From _____ To _____
Bore Hole Size _____
Type _____
Method _____

From _____ To _____
Hole size 6 1/2" from 77 to 300ft.
Grout
From _____ To _____
Bore Hole Size _____
Type _____
Method _____

Water Zones of Screened Intervals
From 180 To 181
Mesh Size _____ Diam
From 240 To 241
Mesh Size _____ Diam

From 280 To 281
Mesh Size _____ Diam
From _____ To _____
Mesh Size _____ Diam

From _____ To _____
Mesh Size _____ Diam
From _____ To _____
Mesh Size _____ Diam

* Use Data *

Private Well: Domestic _____ Agricultural _____ Industrial _____ Monitoring _____
Public Well: Community _____ Non Community

* Abandonment Information *

Bored or Dry Wells
Casing Removed, Y or N? _____
If Y, Depth to which casing was removed: _____
Depth and Type of Fill: _____
Source of Fill _____
Bentonite Plugs: From _____ to _____ From _____ to _____

Wells other than Bored Wells
Casing removed, Y or N? _____
Depth to which casing was removed: _____
Applicable, depth(s), and type of gravel/sand fill: _____
Source of gravel or sand: _____
Content: From _____ to _____ From _____ to _____

Method of permanently marking location: _____
 Installed watertight top
Suggest setting pump @ approx 280 ft.

COMMONWEALTH OF VIRGINIA
DEPARTMENT OF CONSERVATION

Carl Jackson

Brent Lynn


Stafford

Airport Drive off #610
Drillers Log

Depth Description of Formation or Sediment Remarks

| | | |
|----|-----|-------------------------|
| 0 | 10 | Red Clay |
| 10 | 65 | Micae formation / Brown |
| 65 | 79 | Brown Shale |
| 79 | 300 | Light Gray Granite |

DIAGRAM
(NOT TO SCALE)

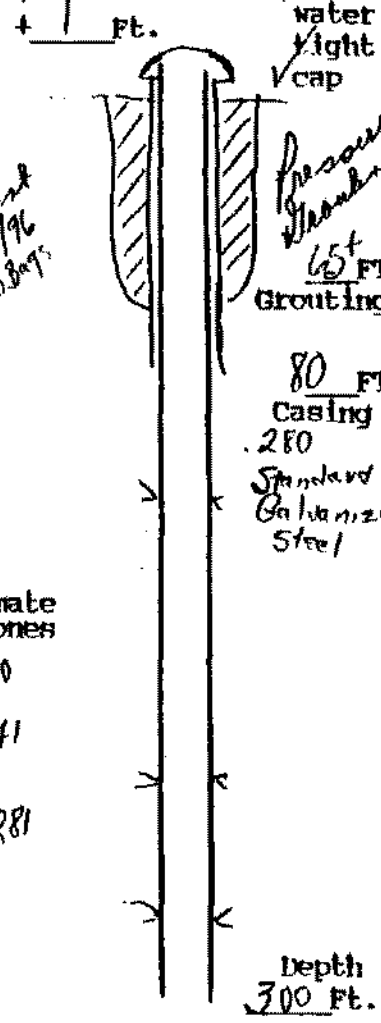

Cement
11/1/96
4 bags

Approximate
Water Zones
180 to 180
240 to 241
and
280 to 281

(Use additional Sheets if necessary)

I certify that the information contained here is true and that this well was installed and constructed in accordance with the permit and further that the well complies with all applicable state and local regulations, ordinances and laws.

Name JOHN L. DANIELSON, JR., INC.
Address 4616 HOOD DRIVE
FREDERICKSBURG, VIRGINIA 22408
Phone 540 (703) 898-6025 / 890-9355

Drillers Signature John L. Danielson, President
Date 11/1/96 Representing JOHN L. DANIELSON, JR., INC.

Virginia Contractors License Number CLASS A 2701 014084A 11/11 WW