

**Commonwealth of Virginia
Uniform Water Well Completion Report**

9-9-4

Owner John Haugh II
 Address 29 Susan Court
Stafford Va 22554
 Phone 659-9419
 Location Green Acres #4

Tax Map ID X-98-X
 VDH Permit W-96-396
 WVCB Permit _____
 WVCB ID _____

Well Classification IIIA IIIB IIIC IV

County Stafford
Approx 74 ft. North of 610 E Green Acres Drive
12/2/96 Dalton B. Wright

* Well Data *

SFF

General Information

Drilling Method Air Rotary
 Depth to Bedrock 67
 Static Water Level 10'
 Well Disinfected (Y or N) _____

Date Completed 3/27/97
 Yield 30 (GPM)
 Stabilized Water Level approx 80'
 Disinfectant Used _____

Total Depth of Well 160'
 Length of Test approx 1 Hr.
 Natural Flow (Rate) _____
 Amount Used _____

Casing

From 1 To 67
 Size 4 1/4" Material P.V.C.
 Weight/Schedule SDR 27

From 55 To 115
 Size 4" Material P.V.C.
 Weight/Schedule Sch 40

From 135 To 160
 Size 4" Material P.V.C.
 Weight/Schedule Sch 40

Gravel Pack

From _____ To _____

From _____ To _____

From _____ To _____

Hole size

10" from 0 to 60 ft.

7 7/8" from 60 to 67 ft.

4 1/4" from 67 to 160 ft.

Grout

From 0 To 50'
 Bore Hole Size 10"
 Type Bestosite
 Method Pressure Grouting

From _____ To _____
 Bore Hole Size _____
 Type _____
 Method _____

From _____ To _____
 Bore Hole Size _____
 Type _____
 Method _____

Water Zones or Screened Intervals

From 115 To 135
 Mesh Size 0.075 Diam 4" (P.V.)
 From _____ To _____
 Mesh Size _____ Diam _____

approx. water zone
 From 130 To 131
 Mesh Size _____ Diam _____
 From _____ To _____
 Mesh Size _____ Diam _____

From _____ To _____
 Mesh Size _____ Diam _____
 From _____ To _____
 Mesh Size _____ Diam _____

* Use Data *

Private Well: Domestic Agricultural _____ Industrial _____ Monitoring _____
 Public Well: Community _____ Non Community _____

* Abandonment Information *

Bored or Dug Wells

Casing Removed, Y or N? _____
 If Y, Depth to which casing was removed: _____
 Depth and Type of Fill: _____
 Source of Fill _____
 Bentonite Plugs: From _____ to _____ From _____ to _____

Wells other than Bored Wells

Casing removed, Y or N? _____
 Depth to which casing was removed: _____
 Applicable, depth(s), and type of gravel/sand fill: _____
 Source of gravel or sand: _____
 Cement: From _____ to _____ From _____ to _____

Method of permanently marking location: _____


Installed watertight top
 Suggest setting pump @ approx. 100 ft.

you will encounter 4" casing @ approx. 55 ft.
Suggest keeping centralizers & torque arrestors out
of 4" casing

John Haugh II
Greentrees # 4
Stafford
 approx 3/4 m. North of 610 E Green Acres Drive
 Drillers Log

Depth Description of Formation or Sediment Remarks

0	10	Red Clay	
10	30	Micaceous formation / Red	
30	55	Micaceous formation / Brown	
55	67	Brown Shale	set 4" P.V.C. Well casing & Screen due to the softness of the formation
67	160	Blue Shale	

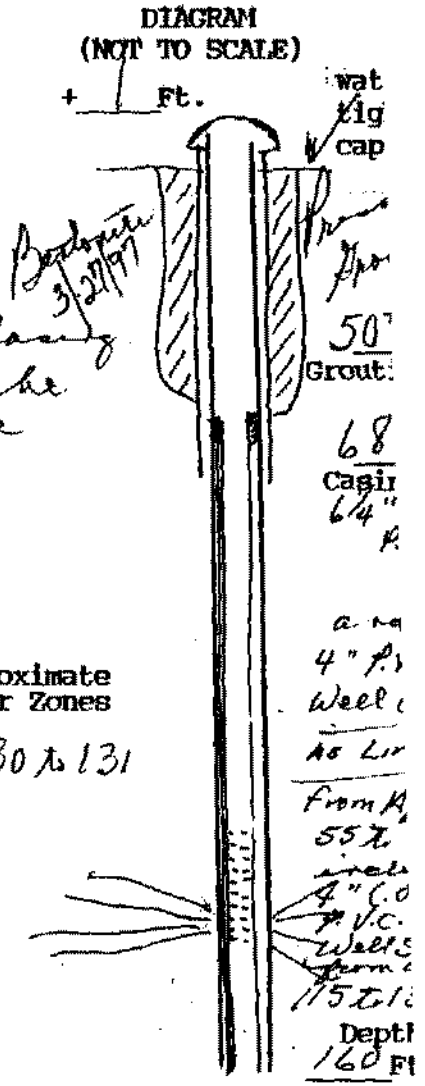

Approximate Water Zones

130 to 131

(User additional Sheets if necessary)

I certify that the information contained here is true and that this well was installed and constructed in accordance with the permit and further that the well complies with all applicable state and local regulations, ordinances and laws.

Name JOHN L. DANIELSON, JR., INC.
 Address 4616 HOOD DRIVE
FREDERICKSBURG, VIRGINIA 22408
 Phone 540 (203) 898-6025 / 898-9355

Drillers Signature John L. Danielson, Pres.
 Date 3/27/97 Representing JOHN L. DANIELSON, JR., INC.

Virginia Contractors License Number CLASS A 2701 014084A H/H WVC