

# Commonwealth of Virginia Uniform Water Well Completion Report

Owner Robert Stockner  
 Address 7404 Emerald Dr.  
Manassas VA 22110  
 Phone 703 335 2209  
 Location Barrington Woods Subd./Lot 11/Stafford

Tax Map ID 189-90-194  
17C-11  
 VDH Permit \_\_\_\_\_  
 WVCB Permit \_\_\_\_\_  
 WVCB ID \_\_\_\_\_  
 County Stafford

### \* Well Data \*

#### General Information

Drilling Method Air Rotary  
 Depth to Bedrock 60  
 Static Water Level 40  
 Well Disinfected (Y or N) N

Date Completed 7/15/92  
 Yield 6 (GPM)  
 Stabilized Water Level \_\_\_\_\_  
 Disinfectant Used \_\_\_\_\_

Total Depth of Well 405  
 Length of Test 2hrs  
 Natural Flow (Rate) \_\_\_\_\_  
 Amount Used \_\_\_\_\_

#### Casing

From +1 to 119  
 Size 6 1/2 Material PVC  
 Weight/Schedule 40

From \_\_\_\_\_ to \_\_\_\_\_  
 Size \_\_\_\_\_ Material \_\_\_\_\_  
 Weight/Schedule \_\_\_\_\_

From \_\_\_\_\_ to \_\_\_\_\_  
 Size \_\_\_\_\_ Material \_\_\_\_\_  
 Weight/Schedule \_\_\_\_\_

#### Gravel Pack

From \_\_\_\_\_ to \_\_\_\_\_

From \_\_\_\_\_ to \_\_\_\_\_

From \_\_\_\_\_ to \_\_\_\_\_

#### Grout

From 50 to 0  
 Bore Hole Size 11  
 Type neat  
 Method pressure

From \_\_\_\_\_ to \_\_\_\_\_  
 Bore Hole Size \_\_\_\_\_  
 Type \_\_\_\_\_  
 Method \_\_\_\_\_

From \_\_\_\_\_ to \_\_\_\_\_  
 Bore Hole Size \_\_\_\_\_  
 Type \_\_\_\_\_  
 Method \_\_\_\_\_

#### Water Zones or Screened Intervals


From 125 to 130  
 Mesh Size \_\_\_\_\_ Diam. \_\_\_\_\_  
 From \_\_\_\_\_ to \_\_\_\_\_  
 Mesh Size \_\_\_\_\_ Diam. \_\_\_\_\_

From 250 to 255  
 Mesh Size \_\_\_\_\_ Diam. \_\_\_\_\_  
 From \_\_\_\_\_ to \_\_\_\_\_  
 Mesh Size \_\_\_\_\_ Diam. \_\_\_\_\_

From 390 to 395  
 Mesh Size \_\_\_\_\_ Diam. \_\_\_\_\_  
 From \_\_\_\_\_ to \_\_\_\_\_  
 Mesh Size \_\_\_\_\_ Diam. \_\_\_\_\_

### \* Use Data \*

Private Well: Domestic  Agricultural \_\_\_\_\_ Industrial \_\_\_\_\_ Monitoring \_\_\_\_\_  
 Public Well: Community \_\_\_\_\_ Non Community \_\_\_\_\_

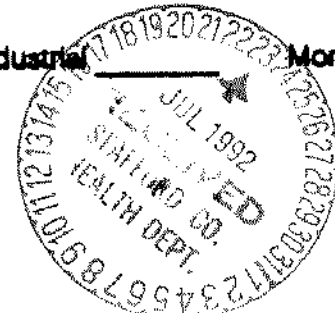

**Drillers Log \***  
(Use additional sheets if necessary)

| Depth     | Description of Formation or Sediment |
|-----------|--------------------------------------|
| 0 - 20    | Clay tight orange                    |
| 20 - 60   | Clay brown                           |
| 60 - 120  | Rock soft brown w/mud voids          |
| 120 - 405 | Rock blue-gray granite w/voids       |

I certify that the information contained here is true and that this well was installed and constructed in accordance with the permit and further that the well complies with all applicable state and regulations, ordinances and laws.

Drilling Contractor Van's construction  
Address P O Box 3306  
Fred'bg VA 22402  
Phone 703 373 7502

Drillers Signature Bill Van Hoey Date 7-15-92  
Representing Van's Construction  
Virginia Contractors License Number 2701018610