

Bill Hornes / Roger Craft. 4659-4750
152 Jefferson Davis Highway Suite 107-39
Stafford Va. 22454 Commonwealth of Virginia
0. 726-6688 Fax 720-5751 Uniform Water Well Completion Report

Contract #
 Owner Harwell Development/Arb Hill Farms - For Sale
 Address P.O. Box 374
Garrisonville, Va 22463
 Phone 659-6172
 Location Harwell Acres # 12 off 616
183A
 Well Classification IIIA III B III C IV
 * Well Data *

Tax Map ID 17D-12
 VDH Permit SW-94-124
 VWCB Permit _____
 VWCB ID _____
 County STAFFORD
6/1/94 Ashton B. Wright
6/2/94 J.J. Thompson

General Information
 Drilling Method Air Rotary
 Depth to Bedrock 15
 Static Water Level 20'
 Well Disinfected (Y or N) _____

Date Completed 11/7/94
 Yield 15 (GPM)
 Stabilized Water Level _____
 Disinfectant Used _____

Total Depth of Well 220'
 Length of Test approx 1 Hr.
 Natural Flow (Rate) _____
 Amount Used _____

Casing
 From 4' To 37
 Size 6 1/4 Material STEEL
 Weight/Schedule .188 / 13.6 per ft.

From _____ To _____
 Size _____ Material _____
 Weight/Schedule _____

From _____ To _____
 Size _____ Material _____
 Weight/Schedule _____

Gravel Pack
 From _____ To _____
 Hole size 10" from 0 to 37 ft.
 Grout
 From 0 To _____
 Bore Hole Size 10" 7/12/94
 Type Bentonite
 Method Pressure Grouting

From _____ To _____
 Hole size 6 1/8" from 37 to 220 ft.
 Grout
 From _____ To _____
 Bore Hole Size _____
 Type _____
 Method _____

From _____ To _____
 Hole size _____ from _____ to _____ ft.
 Grout
 From _____ To _____
 Bore Hole Size _____
 Type _____
 Method _____

Water Zones or Screened Intervals
 From 140 To 141
 Mesh Size _____ Diam _____
 From 200 To 201
 Mesh Size _____ Diam _____

From _____ To _____
 Mesh Size _____ Diam _____
 From _____ To _____
 Mesh Size _____ Diam _____

From _____ To _____
 Mesh Size _____ Diam _____
 From _____ To _____
 Mesh Size _____ Diam _____

* Use Data *
 Private Well: Domestic Agricultural _____ Industrial _____ Monitoring _____
 Public Well: Community _____ Non Community _____

* Abandonment Information *

Bored or Dug Wells
 Casing Removed, Y or N? _____
 If Y, Depth to which casing was removed: _____
 Depth and Type of Fill: _____
 Source of Fill _____
 Bentonite Plugs: From _____ to _____ From _____ to _____


Wells other than Bored Wells 50' Borehole - filled w/ Bentonite
 Casing removed, Y or N? N/A
 Depth to which casing was removed: No casing
 Applicable, depth(s), and type of gravel/sand fill: _____
 Source of gravel or sand: _____
 Cement: From 0 to 80 From _____ to _____
Bentonite

Method of permanently marking location: _____
 Installed watertight top
 Suggest setting pump @ approx. 100 ft.

Artbill Homes
Harwell Acres # 12
Stafford off #1616

* Drillers Log *

Depth	Description of Formation or Sediment	Remarks
0	15	Red Clay
15	37	Broken Rock
37	220	Light Grey Rock

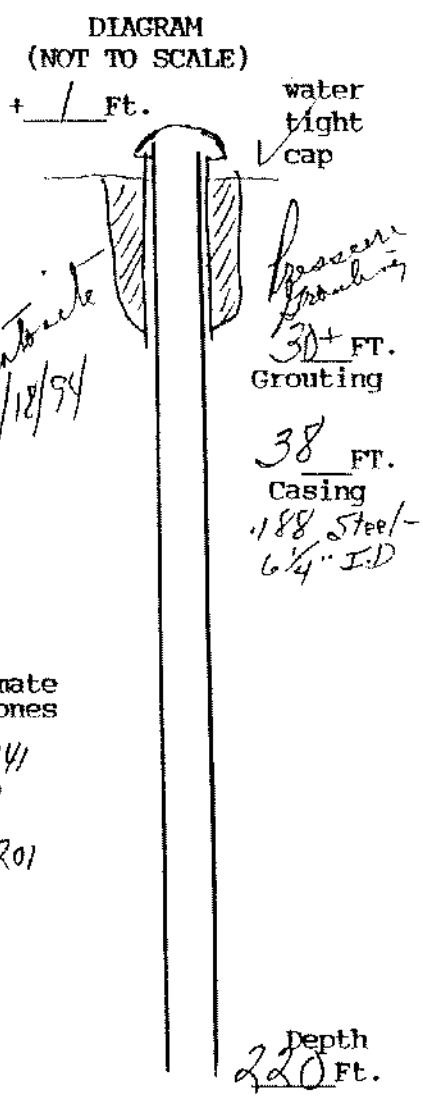

(User additional Sheets if necessary)

I certify that the information contained here is true and that this well was installed and constructed in accordance with the permit and further that the well complies with all applicable state and local regulations, ordinances and laws.

Name JOHN L. DANIELSON, JR., INC.
 Address 4616 HOOD DRIVE
FREDERICKSBURG, VIRGINIA 22408
 Phone (703) 898-6025 / 898-9355

Drillers Signature John L. Danielson, Jr.
 Date 11/18/94 Representing JOHN L. DANIELSON, JR., INC.

Virginia Contractors License Number CLASS A 2701 014084A II/II WWC