

**Commonwealth of Virginia
Uniform Water Well Completion Report**

Ed Ashby
Ashby Homes
45 Melvyn Drive
Stafford 22554
659-9987

Owner Heidi Huntington & Bill? Graves?
Address P.O. Box 1029
Stafford, Va 22555
Phone 659-15484
Location Thompson - Lot 51 116 Misty Lane
183A
Well Classification IIIA IIIB IIIC IV

Tax Map ID 17-51W-B
VDH Permit SW-94-96
VWCB Permit _____
VWCB ID _____
County Stafford
4/6/94 Abb Snyder
T.T. Thompson

* Well Data *

General Information

Drilling Method Air Rotary Date Completed 3/14/95 Total Depth of Well 340
Depth to Bedrock 6.5 Yield 4 (GPM) Length of Test approx 1 Hr.
Static Water Level _____ Stabilized Water Level _____ Natural Flow (Rate) _____
Well Disinfected (Y or N) _____ Disinfectant Used _____ Amount Used _____

Casing
From 4.1 To 6.5 From 60 To 300 From 320 To 340
Size 6.4 Material P.V.C. Size 4" Material P.V.C. Size 4" Material P.V.C.
Weight/Schedule SDR 27 Weight/Schedule Sch 40 Weight/Schedule Sch 40

Gravel Pack
From _____ To _____ From _____ To _____ From _____ To _____
Hole size
10" from 0 to 60 ft. 7 7/8" from 60 to 65 ft. 6 7/8" from 65 to 340 ft.
Grout
From 0 To 50+ From _____ To _____ From _____ To _____
Bore Hole Size 10" 3/14/95 Bore Hole Size _____ Bore Hole Size _____
Type Bentonite Type _____ Type _____
Method Pressure Grouting Method _____ Method _____

Water Zones or Screened Intervals
From 300 To 320 From 200 To 201 From _____ To _____
Mesh Size 20 Diam 4" P.V.C. Mesh Size _____ Diam _____ Mesh Size _____ Diam _____
From _____ To _____ From 308 To 309 From _____ To _____
Mesh Size _____ Diam _____ Mesh Size _____ Diam _____ Mesh Size _____ Diam _____

* Use Data *

Private Well: Domestic Agricultural _____ Industrial _____ Monitoring _____
Public Well: Community _____ Non Community _____

*** Abandonment Information ***


Bored or Dug Wells	Wells other than Bored Wells
Casing Removed, Y or N? _____	Casing removed, Y or N? _____
If Y, Depth to which casing was removed: _____	Depth to which casing was removed: _____
Depth and Type of Fill: _____	Applicable, depth(s), and type of gravel/sand fill: _____
Source of Fill: _____	Source of gravel or sand: _____
Bentonite Plugs: From _____ to _____ From _____ to _____	Cement: From _____ to _____ From _____ to _____

Method of permanently marking location: _____
 Installed watertight top
Suggest setting pump @ approx 300 ft.
- you will encounter 4" casing @ approx 60 ft.
- Suggest keeping centralizer & torque arrestors out of 4" casing.
116 Misty Lane
944 301 Friendship T. 110

Rock Ashby / Ashby Homes
Thompson / Lot 51
Stafford - 116 Misty Lane

• Drillers Log •

Depth	Description of Formation or Sediment	Remarks
0	10	Red Clay
10	40	Mecicous formation / Red
40	60	Mecicous formation / Brown
60	65	Brown Shale
65	340	Blue Shale

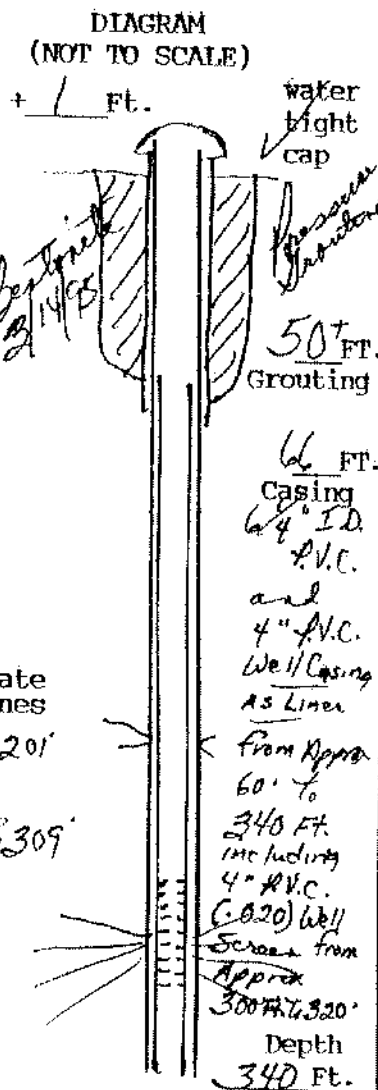

Approximate Water Zones

200' to 201'
 and
 308' to 309'



(User additional Sheets if necessary)

I certify that the information contained here is true and that this well was installed and constructed in accordance with the permit and further that the well complies with all applicable state and local regulations, ordinances and laws.

Name JOHN L. DANIELSON, JR., INC.
 Address 4616 HOOD DRIVE
FREDERICKSBURG, VIRGINIA 22408
 Phone (703) 898-6025 / 898-9355

Drillers Signature [Signature]
 Date 3/15/95 Representing JOHN L. DANIELSON, JR., INC.

Virginia Contractors License Number CLASS A 2701 014084A H/H WWC