

4700 Bang Highway Suite 109-39
Hampton, Va. 22554
720-5751

Commonwealth of Virginia
Uniform Water Well Completion Report

Owner Artbild Ltd / For Sale
Address 2852 Williamsburg Highway Suite 109-39
Hampton, Va. 22554
Phone 720-5751
Location Hamwell Area Sect 1 Lot 5

Tax Map ID 17D-1-5
VDH Permit SWP-95-285
VWCB Permit _____
VWCB ID _____
County Stafford
9/1/95 Estlin B. Wright
DJC

Well Classification IIIA _____ IIIB IIIC _____ IV _____
* Well Data *

General Information
Drilling Method Air Rotary
Depth to Bedrock 25
Static Water Level 30
Well Disinfected (Y or N) _____

Date Completed 12/20/95
Yield 60 (GPM)
Stabilized Water Level 60
Disinfectant Used _____

Total Depth of Well 160
Length of Test approx. 1 Hr.
Natural Flow (Rate) _____
Amount Used _____

Casing
From TL To 64
Size 6/4 Material P.V.C.
Weight/Schedule SDR 27

From _____ To _____
Size _____ Material _____
Weight/Schedule _____

From _____ To _____
Size _____ Material _____
Weight/Schedule _____

Gravel Pack
From _____ To _____
Hole size 10" from 0 to 50 ft.
Grout
From 0 To 50'
Bore Hole Size 10" 12/21/95
Type Bentonite
Method Pressure Grouting

From _____ To _____
Hole size 8" from 50 to 67 ft.
From _____ To _____
Bore Hole Size _____
Type _____
Method _____

From _____ To _____
Hole size 6 1/8" from 67 to 60 ft.
From _____ To _____
Bore Hole Size _____
Type _____
Method _____

Water Zones or Screened Intervals
From 120 To 121
Mesh Size _____ Diam _____
From 150 To 151
Mesh Size _____ Diam _____

From _____ To _____
Mesh Size _____ Diam _____
From _____ To _____
Mesh Size _____ Diam _____

From _____ To _____
Mesh Size _____ Diam _____
From _____ To _____
Mesh Size _____ Diam _____

* Use Data *

Private Well: Domestic Agricultural _____ Industrial _____ Monitoring _____
Public Well: Community _____ Non Community _____

* Abandonment Information *

Bored or Dug Wells
Casing Removed, Y or N?: _____
If Y, Depth to which casing was removed: _____
Depth and Type of Fill: _____
Source of Fill _____
Bentonite Plugs: From _____ to _____ From _____ to _____

Wells other than Bored Wells
Casing removed, Y or N? _____
Depth to which casing was removed: _____
Applicable, depth(s), and type of gravel/sand fill: _____
Source of gravel or sand: _____
Cement: From _____ to _____ From _____ to _____


Method of permanently marking location: _____
 Installed watertight top
Suggest setting pump @ approx. 80 ft.

on State of Virginia
 Department of Health
 Environmental Health Agency/Corporation

Artbill / Joe Sale
Haywell Acres # 5
Stafford
17-5-666

* Drillers Log *

Depth	Description of Formation or Sediment	Remarks
0	25	Brown Clay
25	46	Brown Shale
46	160	Light Gray Rock

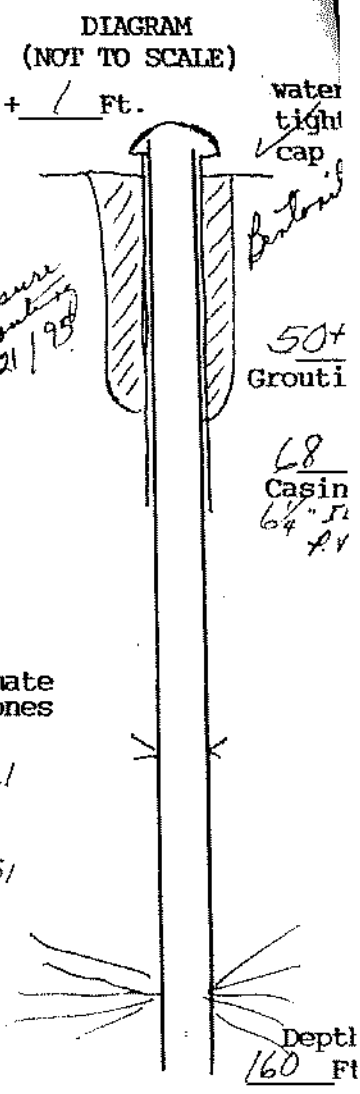

Approximate Water Zones
 120 to 121
 and
 150 to 151

(User additional Sheets if necessary)

I certify that the information contained here is true and that this well was installed and constructed in accordance with the permit and further that the well complies with all applicable state and local regulations, ordinances and laws.

Name JOHN L. DANIELSON, JR., INC.
 Address 4616 HOOD DRIVE
FREDERICKSBURG, VIRGINIA 22408
 Phone (703) 898-6025 / 898-9355

Drillers Signature *John L. Danielson, Jr.*
 Date 2/21/98 Representing JOHN L. DANIELSON, JR., INC.

Virginia Contractors License Number CLASS A 2701 014084A H/H WMC