

Bill Nease
2852 Jefferson Davis Highway, Suite 109-39
Stafford Va. 22554
720-5751 720-7876
1-344-6385

Commonwealth of Virginia
Uniform Water Well Completion Report

Owner Artbell Ltd Partnership / For Sale
Address 2852 Jefferson Davis Highway, Suite 109-39
Stafford Va. 22554
Phone 720-6686 Fax 720-5751
Location Harwill Acrea #7

Tax Map ID 170-7
VDH Permit SWP-95-52
VWCB Permit _____
VWCB ID _____
County STAFFORD
3/9/95 Daniel J. Jacobyn
SFF

Well Classification IIIA _____ IIIB IIIC _____ IV _____
* Well Data *

General Information
Drilling Method Air Rotary Date Completed 5/11/95 Total Depth of Well 200
Depth to Bedrock _____ Yield 30 (GPM) Length of Test approx 1 Hr
Static Water Level 380 Stabilized Water 380 Natural Flow (Rate) _____
Well Disinfected (Y or N) _____ Disinfectant Used _____ Amount Used _____

Casing
From 1 To 85 From 80 To 160 From 180 To 200
Size 6 1/4" Material P.V.C. Size 4" Material P.V.C. Size 4" Material P.V.C.
Weight/Schedule SDR 27 Weight/Schedule Sch 40 Weight/Schedule Sch 40

Gravel Pack
From _____ To _____ From _____ To _____ From _____ To _____
Hole size 10" from 0 to 60ft. 7 7/8" from 60 to 85 ft. 6 1/8" from 85 to 200ft.
Grout
From 0 To 60+ From _____ To _____ From _____ To _____
Bore Hole Size 10" Bore Hole Size _____ Bore Hole Size _____
Type Bentonite Type _____ Type _____
Method Pressure Grouting Method _____ Method _____

Water Zones or Screened Intervals
From 160 To 180 From 160 To 161 From _____ To _____
Mesh Size 1020 Diam 4" P.V.C. Mesh Size _____ Diam _____ Mesh Size _____ Diam _____
From _____ To _____ From _____ To _____ From _____ To _____
Mesh Size _____ Diam _____ Mesh Size _____ Diam _____ Mesh Size _____ Diam _____

* Use Data *

Private Well: Domestic Agricultural _____ Industrial _____ Monitoring _____
Public Well: Community _____ Non Community _____

* Abandonment Information *

Bored or Dug Wells
Casing Removed, Y or N? _____
If Y, Depth to which casing was removed: _____
Depth and Type of Fill: _____
Source of Fill: _____
Bentonite Plugs: From _____ to _____ From _____ to _____
Cement: From _____ to _____ From _____ to _____

Wells other than Bored Wells
Casing removed, Y or N? _____
Depth to which casing was removed: _____
Applicable, depth(s), and type of gravel/sand fill: _____
Source of gravel or sand: _____


Method of permanently marking location:
 Installed watertight top
Suggest setting pump @ approx. 120 ft.
You will encounter 4" casing @ approx 80 ft.
Suggest keeping bentonite & torque armatures out
of 4" casing.

Arthur Thomas
Harwell Acres #7
Shapiro
 5/11/95

* Drillers Log *

Depth Description of Formation or Sediment Remarks

0	10	Sandy Red Clay	
10	40	Micaceous formation / Red	
40	60	Micaceous formation / Brown	
60	85	Brown Shale	Set 4" P.V.C. due to the softness of the formation.
85	200	Blue Shale	

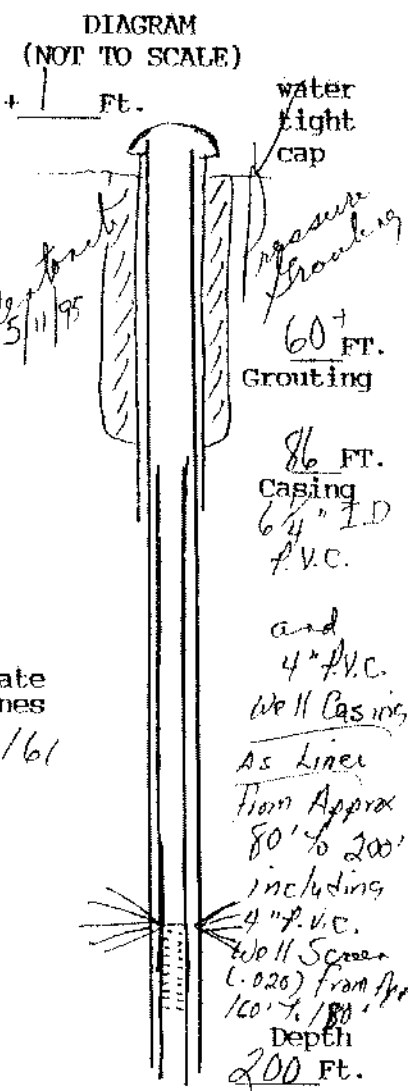

Approximate Water Zones
 160 to 161



(User additional Sheets if necessary)

I certify that the information contained here is true and that this well was installed and constructed in accordance with the permit and further that the well complies with all applicable state and local regulations, ordinances and laws.

Name JOHN L. DANIELSON, JR., INC.
 Address 4615 HOOD DRIVE
FREDERICKSBURG, VIRGINIA 22408
 Phone (703) 898-6025 / 898-9355

Drillers Signature John L. Danielson, Pres.
 Date 5/11/95 Representing JOHN L. DANIELSON, JR., INC.

Virginia Contractors License Number CLASS A 2701 014084A H/H WWC