

Artbuilt Homes
2852 Jeff Davis Highway Suite 109-39
Stafford, Va. 22554
720-5751

Commonwealth of Virginia
Uniform Water Well Completion Report

Owner Artbuilt Homes
Address 2852 Jeff Davis Highway Suite 109-39
Stafford, Va. 22554
Phone 720-5751 F. 720-5751?
Location Harwell Acres #2 10 Harley Court
17 → 616 → Harwell Acres

Tax Map ID 17D-2
VDH Permit SWP-96-71
VWCB Permit _____
VWCB ID _____
County STAFFORD
4/1/96 Ashton Wright

Well Classification IIIA _____ IIIB IIIC _____ IV _____
* Well Data *

DJC

General Information

Drilling Method Air Rotary
Depth to Bedrock 65'
Static Water Level 30
Well Disinfected (Y or N) _____

Date Completed 7/3/96
Yield 6 (GPM)
Stabilized Water Level 280
Disinfectant Used _____

Total Depth of Well 320'
Length of Test approx 1 Hr.
Natural Flow (Rate) _____
Amount Used _____

Casing

From 41 To 79
Size 6 1/4" Material P.V.C.
Weight/Schedule J.D.R. 27

From _____ To _____
Size _____ Material _____
Weight/Schedule _____

From _____ To _____
Size _____ Material _____
Weight/Schedule _____

Gravel Pack

From _____ To _____

From _____ To _____

From _____ To _____

Hole size 10" from 0 to 50 ft.

7 7/8" from 50 to 79 ft.

6 1/8" from _____ to _____ ft.

Grout From 0 To 50' 7/9

From _____ To _____

From _____ To _____

Bore Hole Size 10"
Type Bentonite 1/96
Method Pressure Grouting

Bore Hole Size _____
Type _____
Method _____

Bore Hole Size _____
Type _____
Method _____

Water Zones or Screened Intervals

From 160 To 161
Mesh Size _____ Diam _____
From 270 To 271
Mesh Size _____ Diam _____

From _____ To _____
Mesh Size _____ Diam _____
From _____ To _____
Mesh Size _____ Diam _____

From _____ To _____
Mesh Size _____ Diam _____
From _____ To _____
Mesh Size _____ Diam _____

* Use Data *

Private Well: Domestic Agricultural _____ Industrial _____ Monitoring _____
Public Well: Community _____ Non Community _____

* Abandonment Information *

Bored or Dug Wells

Casing Removed, Y or N? _____
If Y, Depth to which casing was removed: _____
Depth and Type of Fill: _____
Source of Fill _____
Bentonite Plugs: From _____ to _____ From _____ to _____

Wells other than Bored Wells

Casing removed, Y or N? _____
Depth to which casing was removed: _____
Applicable, depth(s), and type of gravel/sand fill: _____
Source of gravel or sand: _____
Cement: From _____ to _____ From _____ to _____

Method of permanently marking location: Installed watertight top
Suggest setting pump @ approx. 300 ft.

961112 (10 Harley Court)

Top 2

Artbuilt Homes


For Sale

Harwell Acres #2 (10 Harley Court)

Stafford #
off 616

* Drillers Log *

Depth	Description of Formation or Sediment	Remarks
0	10	Red Clay
10	65	Brown Clay
65	79	Brown Shale
79	150	Brown Rock
150	320	Light Grey Rock

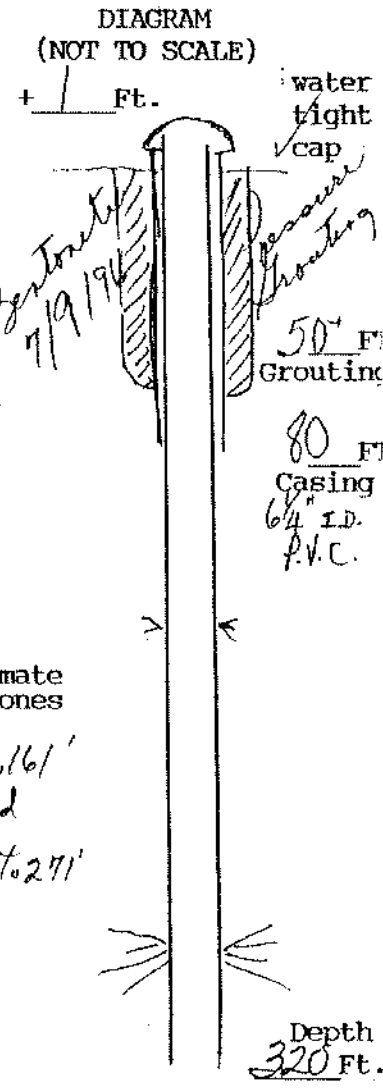

Approximate Water Zones

160' to 161'
and
270' to 271'

(User additional Sheets if necessary)

I certify that the information contained here is true and that this well was installed and constructed in accordance with the permit and further that the well complies with all applicable state and local regulations, ordinances and laws.

Name JOHN L. DANIELSON, JR., INC.
Address 4616 HOOD DRIVE
FREDERICKSBURG, VIRGINIA 22408
Phone 540 (703) 898-6025 / 898-9355

Drillers Signature John L. Danielson, Pres.
Date 7/9/96 Representing JOHN L. DANIELSON, JR., INC.

Virginia Contractors License Number CLASS A 2701 014084A H/H WWC