

W. Ship Bryant Jr.
Bryant Construction
254 Poplar Rd.
Halifax, Va. 22405
752-4567

Commonwealth of Virginia
Uniform Water Well Completion Report

Owner: Stephan Lucille Jones
Address: 28 Tacka #2 Mill Rd.
Phone: 752-4873
Location: #646 / 1st Driveway on Right / Eo.M. from #616

Tax Map ID: 17-50 H
VDH Permit: WS-92-288
VWCB Permit: _____
VWCB ID: _____
County: Stafford
5/3/93 Donald G. Galyer
5/10/93 J.J. Thompson

Classification: IIIA IIIB IIIC IV
2/10 M. East of Inter * 656/616 * Well Data *
1/10 M. S. 1 * 656

Drilling Method: Air Rotary
Date Completed: 3/24/94
Depth to Bedrock: 12'
Yield: 40 (GPM)
Water Level: 40'
Stabilized Water Level: 80'
Disinfected (Y or N): _____
Disinfectant Used: _____

Total Depth of Well: 200
Length of Test: NR.
Natural Flow (Rate): _____
Amount Used: _____

Casing From: +1 To: 6.8
Size: 6 1/4" Material: P.V.C.
Weight/Schedule: SDR 27

From: 6.0 To: 16.0
Size: 4" Material: P.V.C.
Weight/Schedule: Sch. 40

From: 1.80 To: 2.00
Size: 4" Material: P.V.C.
Weight/Schedule: Sch 40

Gravel Pack From: _____ To: _____
Grout From: 0 To: 50'
Grout Hold Size: 1/4"
Type: Bentonite
Method: Pressure Grouting
Date: 3/24/94

From: _____ To: _____
From: _____ To: _____
Bore Hole Size: _____
Type: _____
Method: _____

From: _____ To: _____
From: _____ To: _____
Bore Hole Size: _____
Type: _____
Method: _____

Zones or Screened Intervals
From: 1.60 To: 1.80
Mesh Size: .020 Diam: 4" P.V.C.
From: _____ To: _____
Mesh Size: _____ Diam: _____

From: 1.20 To: 1.21
Mesh Size: _____ Diam: _____
From: 1.70 To: 1.71
Mesh Size: _____ Diam: _____

From: _____ To: _____
Mesh Size: _____ Diam: _____
From: _____ To: _____
Mesh Size: _____ Diam: _____

* Use Data *

Well Type: Domestic Agricultural _____ Industrial _____ Monitoring _____
Public Well: Community _____ Non Community _____

* Abandonment Information *

Bored or Dug Wells
Casing Removed, Y or N?: _____
Y, Depth to which casing was removed: _____
Gravel and Type of Fill: _____
Gravel Source of Fill: _____
Cement Plugs: From _____ to _____ From _____ to _____

Wells other than Bored Wells
Casing removed, Y or N? _____
Depth to which casing was removed: _____
Applicable, depth(s), and type of gravel/sand fill: _____
Source of gravel or sand: _____
Cement: From _____ to _____ From _____ to _____

Method of permanently marking location:
Installed watertight top
Test setting pump @ approx. 100 ft.
will encounter 4" casing @ approx 60 ft.
baseline to be established

Shirley Bryant
Jones

Stafford 646


1st Drive on Right
1/10 M. from #616 Drillers Log *

Depth

Description of Formation or Sediment

Remarks

0	12	Red Clay
12	30	Brown Rock (Shale)
30	200	Dark Grey Rock { set 4" P.V.C. screen due to soft areas in the formation

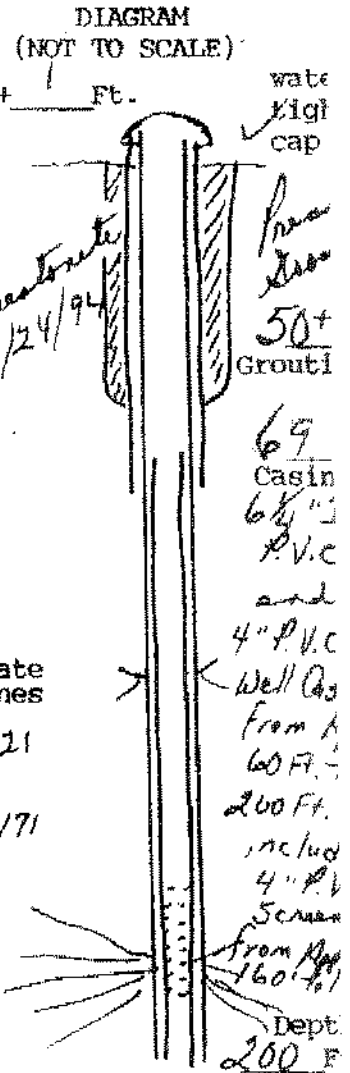

Approximate Water Zones
120 to 121
and
170 to 171

(User additional Sheets if necessary)

I certify that the information contained here is true and that this well was installed and constructed in accordance with the permit and further that the well complies with all applicable state and local regulations, ordinances and laws.

Name JOHN L. DANIELSON, JR., INC.
 Address 4616 HOOD DRIVE
FREDERICKSBURG, VIRGINIA 22408
 Phone (703) 898-6025 / 898-9355

Drillers Signature *John L. Danielson, Jr.*
 Date 3/25/94 Representing JOHN L. DANIELSON, JR., INC.

Virginia Contractors License Number CLASS A 2701 014084A H/H WWC