

Construction

Mark Tolson

461 Mountaineer Rd

Stafford VA 22554-1959
752-0452 22554

Commonwealth of Virginia
Uniform Water Well Completion Report
(Shurley)

Owner Jolson

Address 2482 Mountaineer Road

Phone 752-1010

Location Stafford VA 22554

Tax Map ID 18-56G

VDH Permit W-02-355

VWCB Permit

VWCB ID

County Stafford

7/15/02
John Thorsley
DI

Well Classification IIIA IIIB IIIC IV
* Well Data *

General Information

Drilling Method Air Rotary

Depth to Bedrock 35

Static Water Level 30

Well Disinfected (Y or N)

Date Completed 8/12/02

Yield 6 (GPM)

Stabilized Water Level 240

Disinfectant Used

Total Depth of Well 300

Length of Test

Natural Flow (Rate)

Amount Used

Casing

From +1 To 68

Size 4" Material P.V.C.

Weight/Schedule SJR 27

From 60 To 260

Size 4" Material P.V.C.

Weight/Schedule Sch. 40

From 280 To 300

Size 4" Material P.V.C.

Weight/Schedule Sch. 40

Gravel Pack

From To

From To

From To

Hole size " from to ft.

" from to ft.

" from to ft.

From To 60+

Bore Hole Size 10"

Type Bentonite

Method Pressure Washing

From To

Bore Hole Size

Type

Method

From To

Bore Hole Size

Type

Method

Water Zones or Screened Intervals

From 260 To 280

Mesh Size 020 Diam 4" (P.V.C.)

From To

Mesh Size Diam

From 200 To 201

Mesh Size Diam

From 270 To 271

Mesh Size Diam

From To

Mesh Size Diam

From To

Mesh Size Diam

* Use Data *

Private Well: Domestic

Agricultural

Industrial

Monitoring

Public Well: Community

Non Community

* Abandonment Information *

Bored or Drug Wells

Casing Removed, Y or N?

If Y, Depth to which casing was removed:

Depth and Type of Fill:

Source of Fill

Bentonite Plugs: From to

Wells other than Bored Wells

Casing removed, Y or N?

Depth to which casing was removed:

Applicable, depth(s), and type of gravel/sand fill:

Source of gravel or sand:

Cement: From to

Method of permanently marking location:

Installed watertight top
Suggest setting pump @ approx 260 ft.

You will encounter 4" casing @ approx. 60 ft.
Suggest keeping centralizers & Tongue restrictors out of 4" casing.


Tolson
40 Marjorie Lane
Stafford
 off 627.
 Mountain View

* Driller's Log *

Depth Description of Foundation or Soilment Remarks

0	10	Red Clay
10	45	Grey Shale
45	68	Broken, Fragmented Rock
68	150	Grey Shale
150	300	Grey Granite

Set 4" P.V.C. Well Casing & Screen - as liner due to the softness of the formation

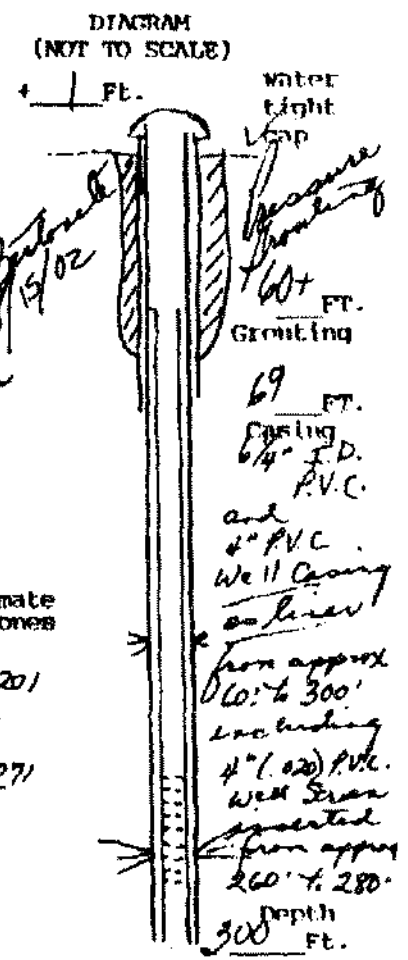

Approximate Water Zones
 200 to 201
 and
 270 to 271

(Use additional Sheets if necessary)

I certify that the information contained here is true and that this well was installed and constructed in accordance with the permit and further that the well complies with all applicable state and local regulations, ordinances and laws

Name JOHN L. DANIELSON, JR., INC.
 Address 4616 HOOD DRIVE
FREDERICKSBURG, VIRGINIA 22408
 Phone (540) 098-6025 / 098-9355

Drillers Signature John L. Danielson, Jr.
 Date 8/15/02 Representing JOHN L. DANIELSON, JR., INC.

Virginia Contractors License Number CLASS A 2701 014081A 11/11 MW