

**COMMONWEALTH OF VIRGINIA
WATER WELL COMPLETION REPORT**

• BWCM No. _____

(Certification of Completion/County Permit)

17-55-1

Water Control Board
Box 11143
191 North Hamilton St.
Richmond, Va. 23230

Tolosa Construction
2432 Mountainview Rd.
Stafford, Va. 22554
752-1010

SWCB Permit _____
County Permit _____
Certification of inspecting official:
This well does _____ does not _____
meet code/low requirements.
S. _____
Date _____

County/City Stafford

County/City Stamp

• Virginia Plane Coordinates
N _____
E _____
Latitude & Longitude
N _____
W _____
• Topo. Map No. 183A
• Elevation _____ ft.
• Formation _____
• Lithology _____
• River Basin _____
• Province _____
• Type Logs D. L.
• Cuttings N. A.
• Water Analysis _____
• Aquifer Test _____

• Owner Leann Hayes For Sale
Rural Home Bldg Skip Cosner
• Well Designation or Number _____
Address _____
Phone _____
• Drilling Contractor John L. Danielson, Jr., Inc.
Address 4616 Hood Drive
Fredericksburg, Virginia 22401
Phone (703) 898-6025

For Office Use

189-88-604 M. Newman
12/188

Tax Map I.D. No. _____
Subdivision _____
Section _____
Block _____
Lot _____
Class Well I _____ IIA _____
IIB _____ IIA ✓ IIB _____
IIC _____ IID _____ IIE _____

WELL LOCATION: _____ (feet/miles _____ direction) of _____

and _____ (feet/miles _____ direction) of _____
(If possible please include map showing location marked)

Date started 9/1/89 • Date completed 9/1/89

1 1/2 Miles N. of Intersection 7610 & 66
Post Mt. Ararat Church
Tolosa Rd
Type rig Air Rotary

Approximate Drawdown 90 feet.

WELL DATA: New Reworked _____ Deepened _____

• Total depth 220 ft.
• Depth to bedrock 25 ft.
• Hole size (Also include reamed zones)
• 10 inches from 0 to 25 ft.
• 6 1/2 inches from 25 to 220 ft.
• _____ inches from _____ to _____ ft.
• Casing size (I.D.) and material
• 6 1/4 inches from +1 to 25 ft.
Material Steel
Wt. per foot 13.4 or wall thickness .188 in.
• _____ inches from _____ to _____ ft.
Material _____
Wt. per foot _____ or wall thickness _____ in.
• _____ inches from _____ to _____ ft.
Material _____
Wt. per foot _____ or wall thickness _____ in.
• Screen size and mesh for each zone (where applicable)
• _____ inches from _____ to _____ ft.
• Mesh size _____ Type _____
• _____ inches from _____ to _____ ft.
• Mesh size _____ Type _____
• Gravel pack
• From _____ to _____ ft.
• From _____ to _____ ft.
• Grout
• From 0 to 20 ft., Type Neat Cement
• From _____ to _____ ft., Type _____

2. WATER DATA • Water temperature _____
• Static water level (unpumped level-measured) 50
• Stabilized measured pumping water level 140
• Stabilized yield 20 gpm after _____ hour
Natural Flow: Yes _____ No flow rate _____ gpm
Comment on quality _____
3. WATER ZONES: From 211 To 212
From _____ To _____ From _____ To _____
From _____ To _____ From _____ To _____
4. USE DATA:
Type of use: Drinking Livestock Watering _____
Irrigation _____ Food processing _____ Household
Manufacturing _____ Fire safety _____ Cleaning _____
Recreation _____ Aesthetic _____ Cooling or heating _____
Injection _____ Other _____
• Type of facility: Domestic Public water supply _____
Public institution _____ Farm _____ Industry _____
Commercial _____ Other _____
5. PUMP DATA: Type _____ • Rated H.P. _____
• Intake depth _____ • Capacity _____ at _____ head
6. WELLHEAD: Type well seal _____
Pressure tank _____ gal., Loc. _____
Sample tap _____ Measurement port _____
Well vent _____ Pressure relief valve _____
Gate valve _____ Check valve (when required) _____
Electrical disconnect switch on power supply _____
7. DISINFECTION: Well disinfected _____ yes _____ no _____
Date _____ Disinfectant used _____
Amount _____ Hours used _____
8. ABANDONMENT (where applicable) • yes _____ no _____
Casing pulled yes _____ no _____ not applicable _____
Plugging grout From _____ to _____ material _____
Pump installed through Tolosa/Rural Home Bldg

Installed Watertight top
Suggest setting pump @ approx 160
OVER

8118
NEW 1970 C.D.E. GREEN

Johann / Rural Home Bldg / Lester Hayes
 Owner SK. Posner
Sheppard - off 6105 675 - Mt. Pleasant Church
Toluca Rd


9. State law requires submitting to the Virginia State Water Control Board information about groundwater and wells for every well intended for water, or any other non-exempt well. This information must be submitted whether the well is completed, on standby, or information required includes: an accurately and completely prepared water well completion report, full data from any aquifer pumping cuttings taken at ten foot intervals (unless exemption is secured), the results of any chemical analyses, and copies of any geophysical logs. Pumpage and use reports are required from owners of public supply and industrial wells. County or State permits to drill may be required in some parts of the state. Some counties require submission of a water well completion report. The Virginia State Health Department requires a water well completion report for public supply wells.

10. DRILLERS LOG (use additional Sheets if necessary)

DEPTH (feet)		TYPE OF ROCK OR SOIL (color, material, fossils, hardness, etc.)	REMARKS (water, casing, cavities, broken, core, shot, (etc.))
From	To		
0	10	red clay	
10	20	micaceous formation brown	
20	25	soft blue rock	
25	220	hard black rock	

Approximate
Water Zones
211 to 212

11. Not 12. DIAGRAM OF WELL To Scale (with dimensions)

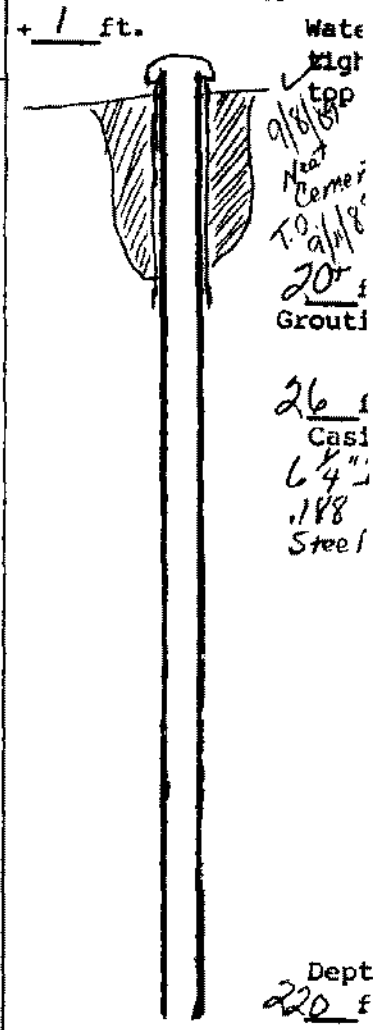

13. Well lot dedicated? _____; Size _____ ft. X _____ ft.; Well house? _____
 Distance to nearest pollutant source _____ ft., Type _____
 Distance to nearest property line _____ ft., Building _____ ft.

14. WATER SERVICE PIPE: Checked under _____ p.s.i. for _____ minutes. Pipe size _____ inches, Material _____
 Installer _____
 Date _____

15. I certify that the information contained herein is true and correct and that this well and/or system has been installed and constructed in accordance with the requirements for well construction as specified in compliance with appropriate county or independent city ordinances and the laws and rules of the Commonwealth of Virginia.
 Signature John T. Danielson (Seal), Date 9/12/89
 License No. _____

- State Water Control Board Regional Offices**
- Valley Reg. Off.
116 North Main Street
P. O. Box 268
Bridgewater, Va. 22812
703-828-2595
 - Southwest Reg. Off.
408 East Main Street
P. O. Box 476
Abingdon, Va. 24210
703-628-5183
 - West Central Reg. Off.
Executive Park
5312 Peters Creek Road
Roanoke, Va. 24019
708-982-7432
 - Piedmont Reg. Off.
4010 West Broad Street
P. O. Box 6616
Richmond, Va. 23230
804-257-1006
 - Tidewater Reg. Off.
287 Pembroke Office Park
Suite 310 Pembroke No. 2
Va. Beach, Va. 23462
804-499-8742
 - Northern Virginia Reg. Off.
5515 Cherokee Avenue
Suite 404
Alexandria, Va. 22312
703-750-9111