

Commonwealth of Virginia
Uniform Water Well Completion Report



19P-25

Owner: Potter Homes, Inc.
Address: 5610 South pointe Centre Blvd.
Fibra VA 22407
Phone: (513) 891-1234
Location: Cherry Hill Est. Lot 25 site 18-m

Tax Map ID: PK 78
VDH Permit: SWP-00-492
VWCB Permit: _____
VWCB ID: _____
County: Stafford

Well Classification IIIA _____ IIIB IIIC _____ IV _____
* Well Data *

General Information

Drilling Method: Air Rotary
Depth to Bedrock: 60'
Static Water Level: 25'
Well Disinfected (Y or N): N

Date Completed: 3/2/01
Yield: 20+ (GPM)
Stabilized Water Level: _____
Disinfectant Used: _____

Total Depth of Well: 360'
Length of Test: 1 hr.
Natural Flow (Rate): N
Amount Used: _____

Casing

From: +1 1/2' To: 88 1/2'
Size: 6 7/8" ID Material: PVC
Weight/Schedule: 3.491 # per ft.
.250 wall

From: _____ To: _____
Size: _____ Material: _____
Weight/Schedule: _____

From: _____ To: _____
Size: _____ Material: _____
Weight/Schedule: _____

Gravel Pack

From: _____ To: _____

From: _____ To: _____

From: _____ To: _____

Hole size

" from _____ to _____ ft.

" from _____ to _____ ft.

" from _____ to _____ ft.

Grout

From: 70' To: 0

From: 88 1/2' To: 70'

From: _____ To: _____

Bore Hole Size: 10" x 8 1/2'

Bore Hole Size: 10" x 8 1/2'

Bore Hole Size: _____

Type: Bentonite E-2 seal

Type: no rock + broken grates

Type: _____

Method: pressure grout from bottom to top

Method: natural cement

Method: _____

Water Zones or Screened Intervals

From: 166' To: 168'

From: 352' To: 354'

From: _____ To: _____

Mesh Size: _____ Diam: _____

Mesh Size: _____ Diam: _____

Mesh Size: _____ Diam: _____

From: _____ To: _____

From: _____ To: _____

From: _____ To: _____

Mesh Size: _____ Diam: _____

Mesh Size: _____ Diam: _____

Mesh Size: _____ Diam: _____

* Use Data *

Private Well: Domestic Agricultural _____ Industrial _____ Monitoring _____
Public Well: Community _____ Non Community _____

* Abandonment Information *

Bored or Dig Wells

Casing Removed Y or N? _____
Y Depth to which casing was removed: _____
Depth and type of fill: _____
Source of fill: _____
Bentonite Plugs From _____ to _____ From _____ to _____

Wells other than Bored Wells

Casing removed, Y or N? _____
Depth to which casing was removed: _____
Applicable, depth(s), and type of gravel/sand fill: _____
Source of gravel or sand: _____
Cement: From _____ to _____ From _____ to _____

Method of permanently marking location: _____

Installed watertight top


* Drillers Log *

NOT TO
Remarks

Depth

Description of Formation or Sediment

0	10'	Red sandy clay
10'	60'	Brown sandy clay
60'	85'	quartz & sandstone (Eased past quartz for stability)
85'	165'	grey med. hardness rock
165'	185'	pinkish / grey rock
185'	360'	grey granite

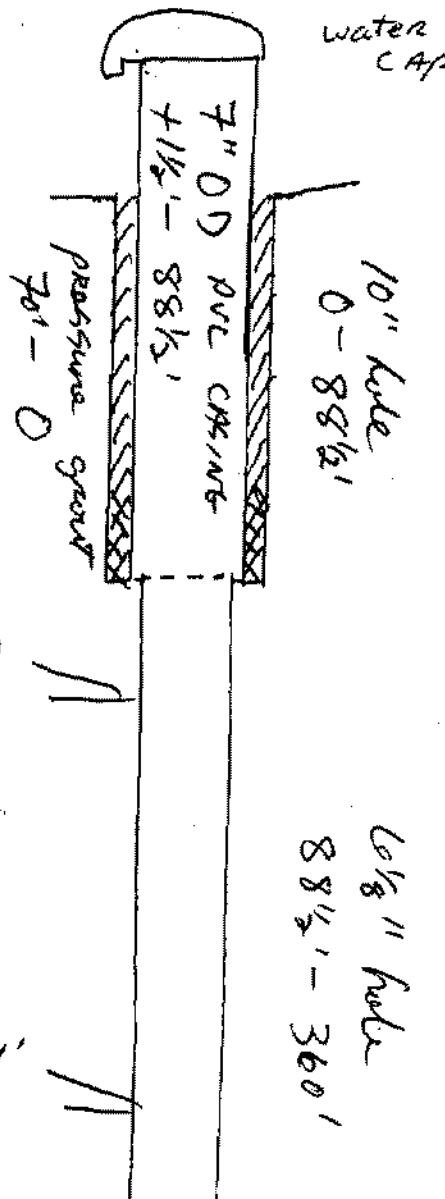

166'-168'
3 GPM

352'-354'
204 GPM

(User additional Sheets if necessary)

I certify that the information contained here is true and that this well was installed and constructed in accordance with the permit and that the well complies with all applicable state and local regulations, ordinances and laws.

Company ARTESIAN WATER WELLS, INC.
 Address 11412 GORDON RD
F. BURG VA 22407
 Phone (540) 285-0163

Drillers Signature Wade M. Smith
 Date 3/2/01 Representing A.W.W.W.

Professional License Number 2705-046112