

Commonwealth of Virginia
Uniform Water Well Completion Report



Owner: Putter Homes, Inc.
Address: 5100 Southpointe Centre Blvd.
Fredericksburg, VA 22407
Phone: (540) 891-1234
Location: Cherry Hill Est. Lot # 3

Tax Map ID: 19P-3
VDH Permit: SWP-01-168
VWCB Permit: _____
VWCB ID: _____
County: Stafford

Well Classification: IIIA _____ IIIB IIIC _____ IV _____
* Well Data *

General Information
Drilling Method: Air Rotary
Depth to Bedrock: 85'
Static Water Level: 40'
Well Disinfected (Y or N): N

Date Completed: 6/29/01
Yield: 4 (GPM)
Stabilized Water Level: _____
Disinfectant Used: _____

Total Depth of Well: 540'
Length of Test: 1 hr.
Natural Flow (Rate): N
Amount Used: _____

Casing From: +1 1/2' To: 128 1/2'
Size: 6 1/4" ID Material: PVC
Weight Schedule: _____

From: _____ To: _____
Size: _____ Material: _____
Weight/Schedule: _____

From: _____ To: _____
Size: _____ Material: _____
Weight/Schedule: _____

Gravel Pack
From: _____ To: _____
Gravel Size: _____
" from _____ to _____ ft.

From: _____ To: _____
" from _____ to _____ ft.

From: _____ To: _____
" from _____ to _____ ft.

From: 80' To: 0
Bore Hole Size: 10" x 128 1/2'
Type: Bentonite E-Z Seal
Method: pressure grout from bottom to top

From: 128 1/2' To: 80'
Bore Hole Size: 10" x 128 1/2'
Type: Cave-in + Natural
Method: backfill

From: _____ To: _____
Bore Hole Size: _____
Type: _____
Method: _____

Water Zones or Screened Intervals
From: 195' To: 197'
Mesh Size: _____ Diam: _____
From: _____ To: _____
Mesh Size: _____ Diam: _____

From: 523' To: 525'
Mesh Size: _____ Diam: _____
From: _____ To: _____
Mesh Size: _____ Diam: _____

From: _____ To: _____
Mesh Size: _____ Diam: _____
From: _____ To: _____
Mesh Size: _____ Diam: _____

* Use Data *

Private Well: Domestic Agricultural _____ Industrial _____ Monitoring _____
Public Well: Community _____ Non Community _____

* Abandonment Information *

Bored or Cug Wells
Casing Removed Y or N? _____
Depth to which casing was removed: _____
Depth and Type of Fill: _____
Source of Fill: _____
Benotone Chgs From _____ to _____ From _____ to _____

Wells other than Bored Wells
Casing removed, Y or N? _____
Depth to which casing was removed: _____
Applicable, depth(s), and type of gravel/sand fill: _____
Source of gravel or sand: _____
Cement: From _____ to _____ From _____ to _____


Method of permanently marking location:
 Installed watertight top

Drillers Log

NOT TO SCALE

Remarks

Depth	Description of Formation or Sediment
0 10'	ORANGE sandy clay
10' 85'	brown sandy clay
85' 115'	soft brown rock
115' 540'	hard grey rock

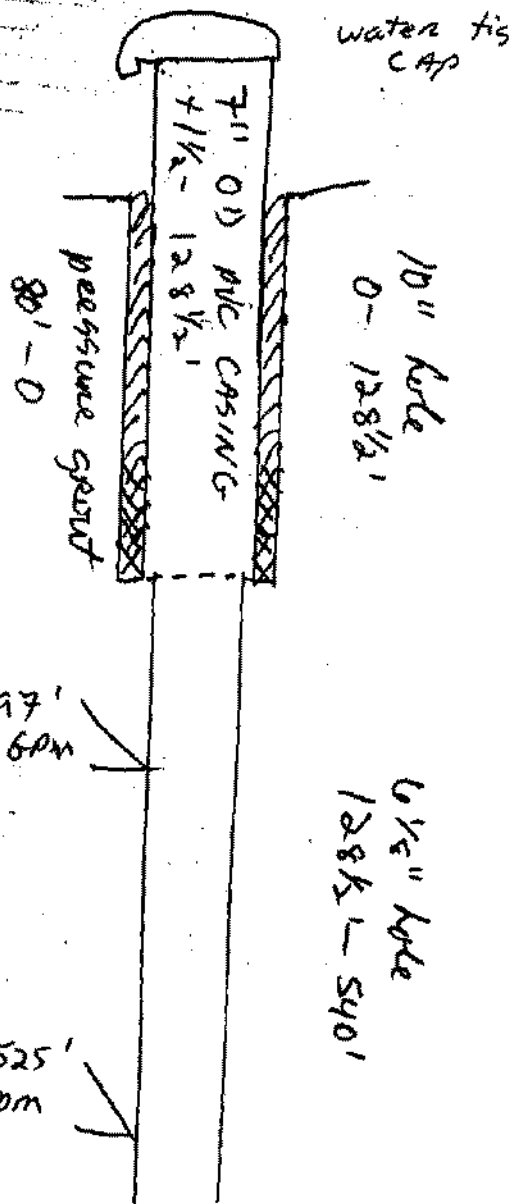

195'-197'
1.5 GPM

523'-525'
2.5 GPM

(User additional Sheets if necessary)

I hereby certify that the information contained here is true and that this well was installed and constructed in accordance with the permit and that the well complies with all applicable state and local regulations, ordinances and laws.

ARTESIAN WATER WELLS, INC.
11412 Gordon Rd
F. BURG VA 22407
(540) 785-8163

Wade M. Dufford
Date 6/29/01 Representing A.W.W.I.

Professional License Number 2705-046112