

Commonwealth of Virginia  
Uniform Water Well Completion Report



Owner: Potter Homes  
Address: 5610 Southcoaste Centre Blvd.  
Ft. Lee, VA 22407  
Phone: (540) 841-1234  
Location: Cherry Hill Lot # 19

Tax Map ID: 19 P-19  
VDH Permit: SWP-01-308  
VWCB Permit: \_\_\_\_\_  
VWCB ID: \_\_\_\_\_  
County: Stafford

Well Classification: IIIA \_\_\_\_\_ IIIB  IIIC \_\_\_\_\_ IV \_\_\_\_\_  
Well Data: \_\_\_\_\_

Special Information  
Drilling Method: Air Rotary  
Depth to Bedrock: 30'  
Static Water Level: 50'  
Well Disinfected (Y or N): N

Date Completed: 9/27/01  
Yield: 1.5 (GPM)  
Stabilized Water Level: \_\_\_\_\_  
Disinfectant Used: \_\_\_\_\_

Total Depth of Well: 540'  
Length of Test: 1 hr.  
Natural Flow (Rate): N  
Amount Used: \_\_\_\_\_

Case # 41 1/2' To 83 1/2'  
Pipe Size: 6 1/4" IG Material: PVC  
Weight/Schedule: 3.441 # per ft.  
.250 wall

From \_\_\_\_\_ To \_\_\_\_\_  
Size \_\_\_\_\_ Material \_\_\_\_\_  
Weight/Schedule \_\_\_\_\_

From \_\_\_\_\_ To \_\_\_\_\_  
Size \_\_\_\_\_ Material \_\_\_\_\_  
Weight/Schedule \_\_\_\_\_

Casing Pipe  
From \_\_\_\_\_ To \_\_\_\_\_

From \_\_\_\_\_ To \_\_\_\_\_

From \_\_\_\_\_ To \_\_\_\_\_

Well Size  
\_\_\_\_\_ " from \_\_\_\_\_ to \_\_\_\_\_ ft.

\_\_\_\_\_ " from \_\_\_\_\_ to \_\_\_\_\_ ft.

\_\_\_\_\_ " from \_\_\_\_\_ to \_\_\_\_\_ ft.

From 83 1/2' To 0  
Bore Hole Size: 10" x 83 1/2'  
Type: Bentonite E-2 seal  
Method: pressure grout from bottom to top

From \_\_\_\_\_ To \_\_\_\_\_  
Bore Hole Size \_\_\_\_\_  
Type \_\_\_\_\_  
Method \_\_\_\_\_

From \_\_\_\_\_ To \_\_\_\_\_  
Bore Hole Size \_\_\_\_\_  
Type \_\_\_\_\_  
Method \_\_\_\_\_

Water Zones or Screened Intervals  
From 200' To 205'  
Mesh Size \_\_\_\_\_ Diam \_\_\_\_\_  
From \_\_\_\_\_ To \_\_\_\_\_  
Mesh Size \_\_\_\_\_ Diam \_\_\_\_\_

From \_\_\_\_\_ To \_\_\_\_\_  
Mesh Size \_\_\_\_\_ Diam \_\_\_\_\_

\* Use Data \*

Private Well: Domestic  Agricultural \_\_\_\_\_ Industrial \_\_\_\_\_ Monitoring \_\_\_\_\_  
Public Well: Community \_\_\_\_\_ Non Community \_\_\_\_\_

\* Abandonment Information \*

Bored or Bore Wells  
Casing Removed: Y or N? \_\_\_\_\_  
Depth to which casing was removed: \_\_\_\_\_  
Depth and Type of Fill: \_\_\_\_\_  
Source of Fill: \_\_\_\_\_  
Borehole Clogs: From \_\_\_\_\_ to \_\_\_\_\_ From \_\_\_\_\_ to \_\_\_\_\_

Wells other than Bored Wells  
Casing removed, Y or N? \_\_\_\_\_  
Depth to which casing was removed: \_\_\_\_\_  
Applicable, depth(s), and type of gravel/sand fill: \_\_\_\_\_  
Source of gravel or sand: \_\_\_\_\_  
Cement: From \_\_\_\_\_ to \_\_\_\_\_ From \_\_\_\_\_ to \_\_\_\_\_

Method of permanently marking location:  
1 Installed watertight top

ADSF


Professional Seal  
No. 134037  
F.C. Box 709  
Harrisonburg, VA  
22801

Dillers Log

NOT TO SCALE  
Remarks

Depth Description of Formation or Sediment

0 30'	brown sandy clay
30' 80'	soft brown rock
80' 108'	med. hard grey rock
108' 540'	hard grey granite

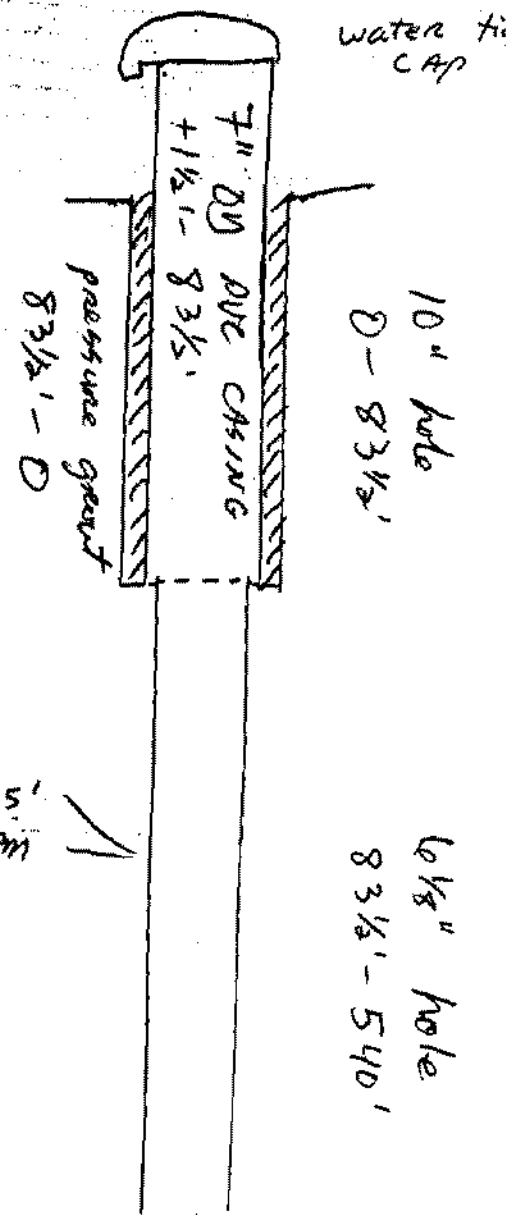

200' - 205'  
1.5 GPM

(Use additional Sheets if necessary)

I hereby certify that the information contained here is true and that this well was installed and constructed in accordance with the permit and that the well complies with all applicable state and local regulations, ordinances and laws.

ARTESIAN WATER WELLS, INC.

11412 GORDON RD

F. BURG VA 22407

(540) 785-8163

Wade A. Duffin

8/27/01 Representing A. W. W. W.

Professional License Number 2705-04612