

Commonwealth of Virginia
Uniform Water Well Completion Report



Owner Potter Homes
Address 5610 South Pointe Ctr Blvd
F15RS VA 22407
Phone (540) 861-1234
Location Cherry Hill Lot #6

Tax Map ID 19P-6
VDH Permit SWP-DI-364
VWCB Permit _____
VWCB ID _____
County Stafford

Well Classification IIIA _____ IIIB IIIC _____ IV _____
* Well Data *

General Information

Drilling Method Air Rotary
Depth to Bedrock 80'
Static Water Level 30'
Well Disinfected (Y or N) N

Date Completed 7/19/01
Yield 20+ (GPM)
Stabilized Water Level _____
Disinfectant Used _____

Total Depth of Well 180'
Length of Test 1 hr.
Natural Flow (Rate) N
Amount Used _____

Casing From +1 1/2' To 118 1/2'
Size 6 1/4" ID Material PVC
Weight/Schedule 3.49 # per ft.

From _____ To _____
Size _____ Material _____
Weight/Schedule _____

From _____ To _____
Size _____ Material _____
Weight/Schedule _____

Gravel Pack

From _____ To _____

From _____ To _____

From _____ To _____

Hole size

" from _____ to _____ ft.

" from _____ to _____ ft.

" from _____ to _____ ft.

Drill

From 80' To 0

From 118 1/2' To 80'

From _____ To _____

Bore Hole Size 10" x 118 1/2'

Bore Hole Size 10" x 118 1/2'

Bore Hole Size _____

Type Bentonite E-2 seal

Type backfill rock cuttings

Type _____

Method pressure grout from bottom to top

Method Natural cave-in

Method _____

Water Zones or Screened Intervals

From 150' To 152'

From 155' To 157'

From _____ To _____

Mesh Size _____ Diam _____

Mesh Size _____ Diam _____

Mesh Size _____ Diam _____

From _____ To _____

From _____ To _____

From _____ To _____

Mesh Size _____ Diam _____

Mesh Size _____ Diam _____

Mesh Size _____ Diam _____

* Use Data *

Private Well Domestic Agricultural _____ Industrial _____ Monitoring _____
Public Well Community _____ Non Community _____

* Abandonment Information *

Bored or Dig Wells

Casing Removed, Y or N? _____

Y: Depth to which casing was removed: _____

Depth and Type of Fill: _____

Source of Fill: _____

Bentonite Chgs From _____ to _____ From _____ to _____

Wells other than Bored Wells

Casing removed, Y or N? _____

Depth to which casing was removed: _____

Applicable, depth(s), and type of gravel/sand fill: _____

Source of gravel or sand: _____

Cement: From _____ to _____ From _____ to _____

Method of permanently marking location: _____

Installed watertight top


ROSE
 (540) 275-8763
 11412 Gordon Rd
 Fairfax, VA 22031

Drillers Log

NOT TO
 Remarks

Depth Description of Formation or Sediment

| | | |
|------|------|----------------------|
| 0 | 10' | brown sandy clay |
| 10' | 30' | tan sandy clay |
| 30' | 40' | brown tan sandy clay |
| 40' | 80' | grey clay |
| 80' | 110' | grey soft rock |
| 110' | 180' | grey granite |

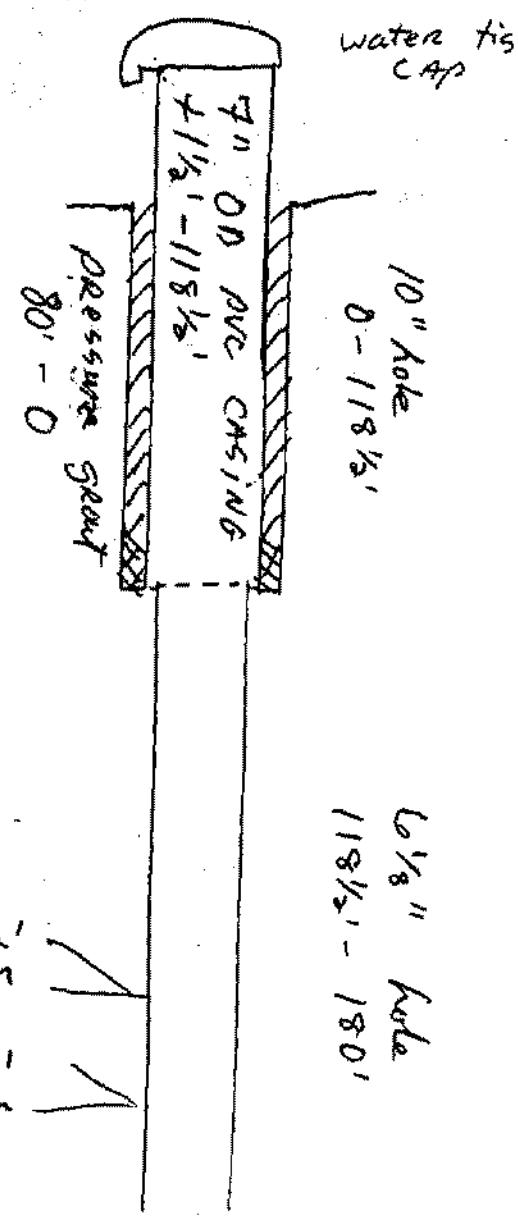

150'-152'
 15+ GPM

155'-157'
 15+ GPM

(User additional Sheets if necessary)

I certify that the information contained here is true and that this well was installed and constructed in accordance with the permit and that the well complies with all applicable state and local regulations, ordinances and laws.

Company ARTESIAN WATER WELLS, INC.
 Address 11412 Gordon Rd
Fairfax VA 22407
 Phone (540) 275-8763
 Date 7/19/01 Representing Walter A. Duff
 License Number 2705-046112