

**Commonwealth of Virginia
Uniform Water Well Completion Report**

Owner Michael Feyer
 Address 1508 Gasparville Road
Stafford, Va. 22557
 Phone 286-16945
 Location Reyer Wagon #3 (20 Keystone Drive)
off 210 / behind Cablevision
 Well Classification IIIA IIIB ✓ IIIC IV
 * Well Data *

Tax Map ID 19-60C
 VDH Permit SWP-96-172
 VWCB Permit _____
 VWCB ID _____
 County Stafford
6/11/96 Daniel Jarschke
SFF

General Information

Drilling Method Air Rotary
 Depth to Bedrock 52
 Static Water Level _____
 Well Disinfected (Y or N) _____

Date Completed 9/24/96
 Yield 11 (GPM)
 Stabilized Water Level _____
 Disinfectant Used _____

Total Depth of Well 160'
 Length of Test approx 1 Hr.
 Natural Flow (Rate) _____
 Amount Used _____

Casing

From 1 To 63
 Size 6 1/4" Material P.V.C.
 Weight/Schedule S.D.R. 27

From _____ To _____
 Size _____ Material _____
 Weight/Schedule _____

From _____ To _____
 Size _____ Material _____
 Weight/Schedule _____

Gravel Pack

From _____ To _____

From _____ To _____

From _____ To _____

Hole size 10" From 0 to 50 ft.

8 1/2" From 50 to 63 ft.

6 1/4" From 63 to 160 ft.

Grout From 0 To 50'
 Bore Hole Size 10" 9/28/96
 Type Grouting
 Method Pressure Grouting

From _____ To _____
 Bore Hole Size _____
 Type _____
 Method _____

From _____ To _____
 Bore Hole Size _____
 Type _____
 Method _____

Water Zones or Screened Intervals

From 140 To 141
 Mesh Size _____ Diam _____
 From _____ To _____
 Mesh Size _____ Diam _____

From _____ To _____
 Mesh Size _____ Diam _____

*** Use Data ***

Private Well: Domestic Agricultural _____ Industrial _____ Monitoring _____
 Public Well: Community _____ Non Community _____

*** Abandonment Information ***

Bored or Dug Wells

Casing Removed, Y or N? _____
 If Y, Depth to which casing was removed: _____
 Depth and Type of Fill: _____
 Source of Fill _____
 Bentonite Plugs: From _____ to _____ From _____ to _____

Wells other than Bored Wells


Casing removed, Y or N? _____
 Depth to which casing was removed: _____
 Applicable, depth(s), and type of gravel/sand fill: _____
 Source of gravel or sand: _____
 Cement: From _____ to _____ From _____ to _____

Method of permanently marking location: _____
 Installed watertight top
 Suggest setting pump @ approx 140 ft.

Michael Keyes
Keyes Lumber Lot 3 (20 Keystone Drive)
Stafford
 off #610 behind Cablevision
 Drillers Log

Depth Description of Formation or Sediment Remarks

0	10	Red Clay
10	30	Micaaceous formation/Red
30	50	Micaaceous formation/Brown
50	63	Brown Shale
63	160	Blue Granite

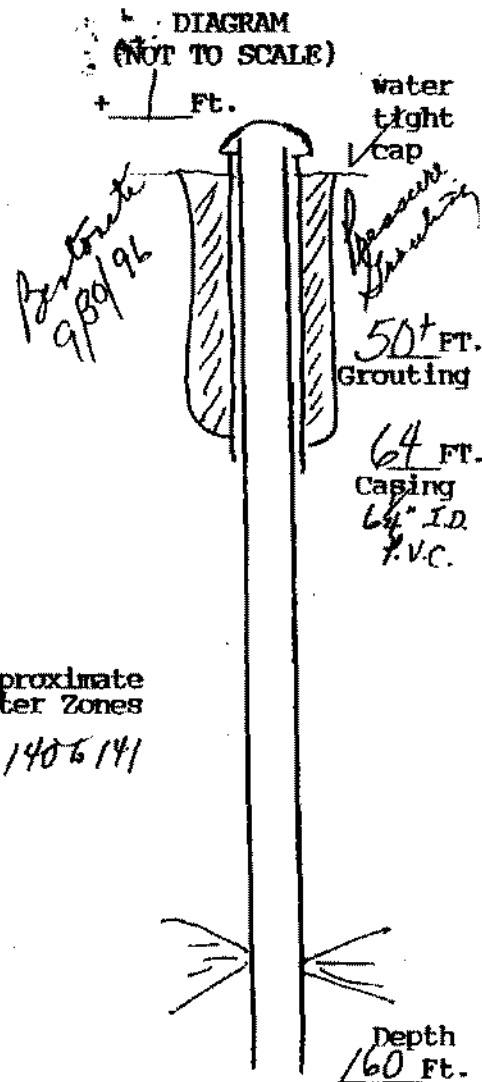

Approximate Water Zones
 1406141

(User additional Sheets if necessary)

I certify that the information contained here is true and that this well was installed and constructed in accordance with the permit and further that the well complies with all applicable state and local regulations, ordinances and laws.

Name JOHN L. DANIELSON, JR., INC.
 Address 4616 HOOD DRIVE
FREDERICKSBURG, VIRGINIA 22408
 Phone 540 (703) 898-6025 / 898-9355

Drillers Signature [Signature]
 Date 9/30/96 Representing JOHN L. DANIELSON, JR., INC.

Virginia Contractors License Number CLASS A 2701 014084A H/H WWC