

**Commonwealth of Virginia  
Uniform Water Well Completion Report**

Owner Tracey Barber  
 Address P.O. Box 2647  
Dale City, Va. 22192  
 Phone 703-241-7700 Fax 1-703-878-6822 P.I. 800-918-0287  
 Location 610 abn 643 / 1409 Garrisonville Rd  
1828  
 Well Classification IIIA IIIB  IIIC IV

Tax Map ID 19-6C  
 VDH Permit SWP-96-389  
 VWCB Permit \_\_\_\_\_  
 VWCB ID \_\_\_\_\_  
 County STAFFORD  
12/27/96 Ashlon Wright  
D.J.C.

\* Well Data \*

**General Information**

Drilling Method Auger/Retam  
 Depth to Bedrock 45  
 Static Water Level 20  
 Well Disinfected (Y or N) \_\_\_\_\_

Date Completed 2/25/97  
 Yield 15 (GPM)  
 Stabilized Water Level 80  
 Disinfectant Used \_\_\_\_\_

Total Depth of Well 140'  
 Length of Test Approx. 1 hr  
 Natural Flow (Rate) \_\_\_\_\_  
 Amount Used \_\_\_\_\_

**Casing**

From 1 To 54  
 Size 6 3/4 Material P.V.C.  
 Weight/Schedule S.D.R. 27

From 40 To 100  
 Size 4" Material P.V.C.  
 Weight/Schedule Sch 40

From 120 To 140  
 Size 4" Material P.V.C.  
 Weight/Schedule Sch. 40

**Gravel Pack**

From \_\_\_\_\_ To \_\_\_\_\_

From \_\_\_\_\_ To \_\_\_\_\_

From \_\_\_\_\_ To \_\_\_\_\_

**Hole size**

10" from 0 to 50 ft.

7 7/8" from 50 to 54 ft.

6 1/8" from 54 to 140 ft.

**Grout**

From 0 To 50' 2/24/97  
 Bore Hole Size 10"  
 Type Bentonite  
 Method Pressure Grouting

From \_\_\_\_\_ To \_\_\_\_\_  
 Bore Hole Size \_\_\_\_\_  
 Type \_\_\_\_\_  
 Method \_\_\_\_\_

From \_\_\_\_\_ To \_\_\_\_\_  
 Bore Hole Size \_\_\_\_\_  
 Type \_\_\_\_\_  
 Method \_\_\_\_\_

**Water Zones or Screened Intervals**

From 100 To 120  
 Mesh Size .016 Diam 4" (P.V.C.)  
 From \_\_\_\_\_ To \_\_\_\_\_  
 Mesh Size \_\_\_\_\_ Diam \_\_\_\_\_

*approx water zones*

From 80 To 81  
 Mesh Size \_\_\_\_\_ Diam \_\_\_\_\_  
 From 110 To 111  
 Mesh Size \_\_\_\_\_ Diam \_\_\_\_\_

From \_\_\_\_\_ To \_\_\_\_\_  
 Mesh Size \_\_\_\_\_ Diam \_\_\_\_\_  
 From \_\_\_\_\_ To \_\_\_\_\_  
 Mesh Size \_\_\_\_\_ Diam \_\_\_\_\_

\* Use Data \*

Private Well: Domestic  Agricultural \_\_\_\_\_ Industrial \_\_\_\_\_ Monitoring \_\_\_\_\_  
 Public Well: Community \_\_\_\_\_ Non Community \_\_\_\_\_

\* Abandonment Information \*

**Bored or Dug Wells**

Casing Removed, Y or N? \_\_\_\_\_  
 If Y, Depth to which casing was removed: \_\_\_\_\_  
 Depth and Type of Fill: \_\_\_\_\_  
 Source of Fill \_\_\_\_\_  
 Bentonite Plugs: From \_\_\_\_\_ to \_\_\_\_\_ From \_\_\_\_\_ to \_\_\_\_\_

**Wells other than Bored Wells**

Casing removed, Y or N? \_\_\_\_\_  
 Depth to which casing was removed: \_\_\_\_\_  
 Applicable, depth(s), and type of gravel/sand fill: \_\_\_\_\_  
 Source of gravel or sand: \_\_\_\_\_  
 Cement: From \_\_\_\_\_ to \_\_\_\_\_ From \_\_\_\_\_ to \_\_\_\_\_

**Method of permanently marking location:**



Installed watertight top  
 Suggest setting pump @ approx. 100 ft.  
You will encounter 4" casing @ approx 40'  
Suggest keeping centralizers & torque arrestors out of 4" casing

Tracy Barber  
 #610 - 1409 Garrisonville Rd.  
Stafford

\* Drillers Log \*

Depth Description of Formation or Sediment Remarks

0	10	Red Clay	set 4" P.V.C. Well Casings Screen due to softness of the formation
10	45	Brown Clay	
45	80	Brown Shale	
80	140	Grey Shale	

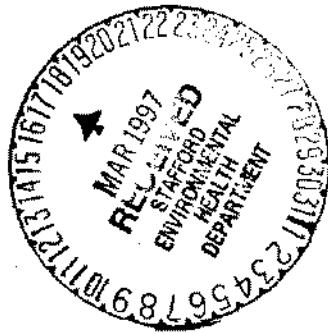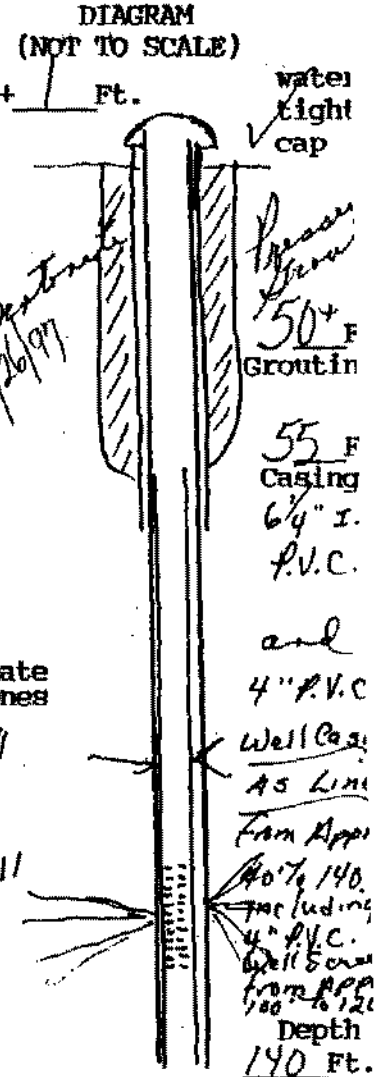

Approximate Water Zones

80 to 81  
and

110 to 111

(User additional Sheets if necessary)

I certify that the information contained here is true and that this well was installed and constructed in accordance with the permit and further that the well complies with all applicable state and local regulations, ordinances and laws.

Name JOHN L. DANIELSON, JR., INC.  
 Address 4616 HOOD DRIVE  
FREDERICKSBURG, VIRGINIA 22408  
 Phone 540 (208) 898-6025 / 898-9355

Drillers Signature John L. Danielson, Pres.  
 Date 2/26/97 Representing JOHN L. DANIELSON, JR., INC.

Virginia Contractors License Number CLASS A 2701 014084A H/H WVC