

Commonwealth of Virginia
Uniform Water Well Completion Report



Owner Potter Homes Tax Map ID 19P-1
 Address 5610 Southpointe Center Blvd Ste 107 DH Permit W-00-4106
Ft. BS, VA 22407
 Phone 891-1234 VWCB Permit _____
 Location Cherry Hill Lot #1 VWCB ID _____
 County Stafford

Well Classification IIIA _____ IIIB IIIC _____ IV _____
 * Well Data *

General Information
 Drilling Method Air Rotary Date Completed 11/07/00 Total Depth of Well 260'
 Depth to Bedrock 65' Yield 7 (GPM) Length of Test 1 hr.
 Static Water Level 30' Stabilized Water Level _____ Natural Flow (Rate) N
 Well Disinfected (Y or N) N Disinfectant Used _____ Amount Used _____
 Casing From 80'-100'; 120'-140'; 160'-180'; 200'-220'; 240'-260'
 From +1 1/2' To 93 1/2' From _____ To _____
 Size 6 1/4" ID Material PVC Size 4.5" Material PVC Size _____ Material _____
 Weight/Schedule 3.491 # per ft. Weight/Schedule 2.781 # per ft. Weight/Schedule _____
.250 WAA .240

Gravel Pack From _____ To _____ From _____ To _____ From _____ To _____
 Hole size _____ " from _____ to _____ " from _____ to _____
 Gravel From 70' To 0 From 93 1/2' To 70' From _____ To _____
 Bore hole size 10" x 9 3/4" Bore hole size 10" x 9 3/4" Bore hole size _____
 Type Bentonite E-2 seal Type backfill rock cuttings Type _____
 Method pressure grout from bottom to top Method from drill rig Method _____

Water Zones or Screened Intervals
 From 100' To 120' From 140' To 160' From 180' To 200'
 Mesh Size .020 Diam 4.5" Mesh Size .020 Diam 4.5" Mesh Size .020 Diam 4.5"
 From 220' To 240' From _____ To _____ From _____ To _____
 Mesh Size .020 Diam 4.5" Mesh Size _____ Diam _____ Mesh Size _____ Diam _____

* Use Data *

Private Well Domestic Agricultural _____ Industrial _____ Monitoring _____
 Public Well Community _____ Non Community _____


* Abandonment Information *

Bored or Dug Wells Wells other than Bored Wells
 Casing Removed, Y or N? _____ Casing removed, Y or N? _____
 Depth to which casing was removed: _____ Depth to which casing was removed: _____
 Depth and Type of Fill: _____ Applicable, depth(s), and type of gravel/sand fill: _____
 Source of Fill: _____ Source of gravel or sand: _____
 Bentonite Plugs From _____ to _____ From _____ to _____ Cement: From _____ to _____ From _____ to _____

Method of permanently marking location: Installed watertight top

NOT TO SCALE

Depth	Description of Formation or Sediment	Remarks
0 - 65'	ORANGE / brown sandy clay	
65' - 90'	soft brown rock to soft to set casing in	
90' - 110'	brown sedimentary rock	
110' - 260'	hard gray rock	

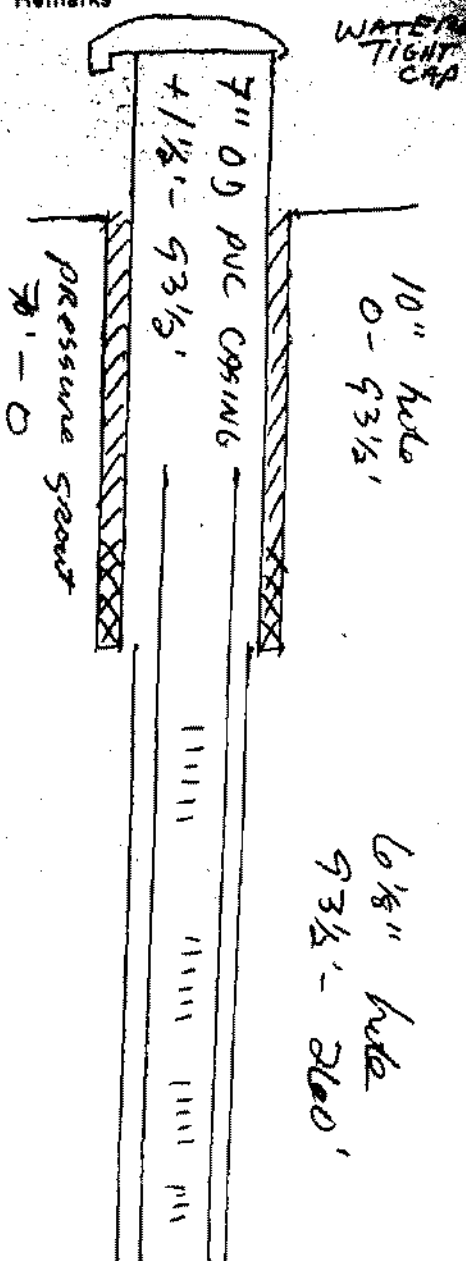

(User additional Sheets if necessary)

I certify that the information contained here is true and that this well was installed and constructed in accordance with the permit and that the well complies with all applicable state and local regulations, ordinances and laws.

Name ARTESIAN WATER WELLS, INC.
 Address 11412 GORDON RD
P.O. BOX VA 22407
 Phone 540-795-8163

Dillers Signature Waldo N. Duff
 Date 11/07/00 Representing A.W.W.

Virginia Contractors License Number 2705-046112