

1052 Garrisonville Rd.

Richard P. Hagan
583
Stafford, Va. 22654
995-9282

Commonwealth of Virginia
Uniform Water Well Completion Report

Owner Manson Martin Pheasant (O/W)
Address 1052 Garrisonville Road
Stafford Va. 22654
Phone 652 4754
Location Toluca Road off 610

Tax Map ID 19-64 (Part of)
VDH Permit WS-92-336
VWCB Permit _____
VWCB ID _____
County Stafford
10/9/92 Robert Anderson
10/9/92 J.S. Thompson

Well Classification IIIA _____ IIIB IIIC _____ IV _____
1/4 M. North of Intersection of 610 & 675 * Well Data *
25 Ft. East of 675

General Information

Drilling Method Air Rotary
Depth to Bedrock 26
Static Water Level 40
Well Disinfected (Y or N) _____

Date Completed 2/17/93
Yield 6 (GPM)
Stabilized Water Level _____
Disinfectant Used _____

Total Depth of Well 300
Length of Test 1 HR
Natural Flow (Rate) _____
Amount Used _____

Casing

From 4 1/2 To 56
Size 6 1/4 Material P.V.C.
Weight/Schedule SDR 29

From _____ To _____
Size _____ Material _____
Weight/Schedule _____

From _____ To _____
Size _____ Material _____
Weight/Schedule _____

Gravel Pack

From _____ To _____

From _____ To _____

From _____ To _____

Hole size

10" from 0 to 56 ft.

6" from 56 to _____ ft.

_____ " from _____ to _____ ft.

Grout

From 0 To 50'

From _____ To _____

From _____ To _____

Bore Hole Size

10"

Bore Hole Size

Bore Hole Size

Type

Bentonite

Type

Type

Method

Pressure Grouting

Method

Method

Water Zones or Screened Intervals

From 200 To 201

From _____ To _____

From _____ To _____

Mesh Size

From 280 To 281

Mesh Size

Mesh Size

* Use Data *

Private Well: Domestic Agricultural _____ Industrial _____ Monitoring _____
Public Well: Community _____ Non Community _____

* Abandonment Information *

Bored or Dug Wells

Casing Removed, Y or N? _____
If Y, Depth to which casing was removed: _____
Depth and Type of Fill: _____
Source of Fill _____
Bentonite Plugs: From _____ to _____ From _____ to _____

Wells other than Bored Wells

Casing removed, Y or N? _____
Depth to which casing was removed: _____
Applicable, depth(s), and type of gravel/sand fill: _____
Source of gravel or sand: _____
Cement: From _____ to _____ From _____ to _____


Method of permanently marking location: _____
 Installed watertight top
Suggest setting pump @ approx. 260 ft.

Permit Builders (Fred & Prose) / own

Rhymer

Stafford - Toluca Rd off 210
(Chambersville)
* Drillers Log *

Depth	Description of Formation or Sediment	Remarks
0	10	Red Clay
10	26	Brown Clay
26	248	Dark Grey Rock (Granite)
248	300	Light Grey Rock (Granite)

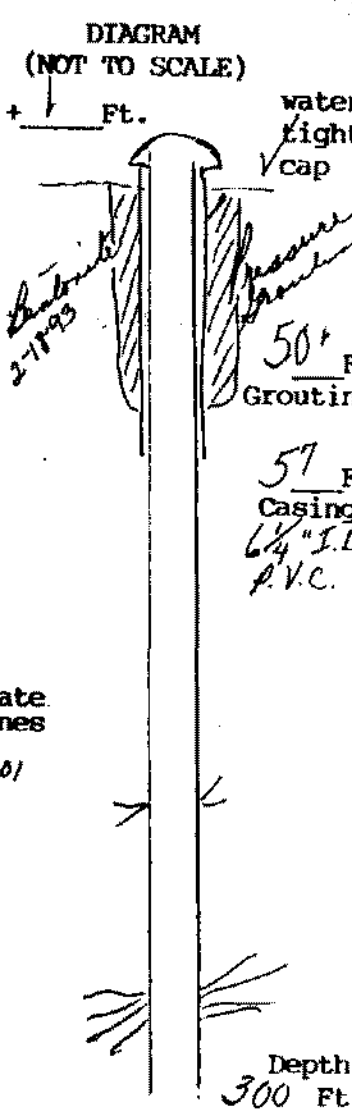

Approximate Water Zones
200 to 201

(User additional Sheets if necessary)

I certify that the information contained here is true and that this well was installed and constructed in accordance with the permit and further that the well complies with all applicable state and local regulations, ordinances and laws.

Name JOHN L. DANIELSON, JR., INC.
 Address 4616 HOOD DRIVE
FREDERICKSBURG, VIRGINIA 22408
 Phone (703) 898-6025 / 898-9355

Drillers Signature John L. Danielson, Inc.
 Date 3/18/93 Representing JOHN L. DANIELSON, JR., INC.

Virginia Contractors License Number _____

3/12 No Wet. Sample Report. Adv. Rob + Joyce with the issue well insp report UMS /
MS report has been seen & approved by Rob!