

Commonwealth of Virginia
Uniform Water Well Completion Report

Permit issued to:

Owner Donald Cox
Address 1509 Garrisonville Rd.
Stafford, Va.
Phone 752-0462
Location *610 -> Key stone Drive / Sect 19 Lot 59A

Mary Ellen Keyes
1509 Garrisonville Rd.
Stafford, Va. 22554
752-0462

Tax Map ID 19-59A
VDH Permit WS-95-261
VWCB Permit _____
VWCB ID _____
County Stafford

9/8/93 Daniel G. Casselgro
9/8/93 J.J. Thompson

Well Classification IIIA IIIB IIIC IV
approx 1/2 m. west of center of 610 & 648
3/10 miles N. of *610
* Well Data *

General Information

Drilling Method Air Rotary
Depth to Bedrock 25'
Static Water Level 40'
Well Disinfected (Y or N) _____

Date Completed 5/10/94
Yield 12 gpm (GPM)
Stabilized Water Level 120
Disinfectant Used _____

Total Depth of Well 240'
Length of Test HR.
Natural Flow (Rate) _____
Amount Used _____

Casing

From 1' To 57'
Size 6 1/4" Material P.V.C.
Weight/Schedule SDR 27

From _____ To _____
Size _____ Material _____
Weight/Schedule _____

From _____ To _____
Size _____ Material _____
Weight/Schedule _____

Gravel Pack

From _____ To _____

From _____ To _____

From _____ To _____

Hole size

10" from 0 to 57 ft.

6 1/8" from 57 to 240 ft.

_____ " from _____ to _____ ft.

Grout

From 0 To 50+
Bore Hole Size 10"
Type Bentonite
Method Pressure Grouting

From _____ To _____
Bore Hole Size _____
Type _____
Method _____

From _____ To _____
Bore Hole Size _____
Type _____
Method _____

Water Zones or Screened Intervals

From 140 To 141
Mesh Size _____ Diam _____
From 220 To 221
Mesh Size _____ Diam _____

From _____ To _____
Mesh Size _____ Diam _____
From _____ To _____
Mesh Size _____ Diam _____

From _____ To _____
Mesh Size _____ Diam _____
From _____ To _____
Mesh Size _____ Diam _____

* Use Data *

Private Well: Domestic Agricultural _____ Industrial _____ Monitoring _____
Public Well: Community _____ Non Community _____

* Abandonment Information *

Bored or Dug Wells

Casing Removed, Y or N? _____
If Y, Depth to which casing was removed: _____
Depth and Type of Fill: _____
Source of Fill: _____
Bentonite Plugs: From _____ to _____ From _____ to _____

Wells other than Bored Wells

Casing removed, Y or N? _____
Depth to which casing was removed: _____
Applicable, depth(s), and type of gravel/sand fill: _____
Source of gravel or sand: _____
Cement: From _____ to _____ From _____ to _____

Method of permanently marking location:

Installed watertight top
Suggest setting pump @ approx. 140 ft.

Donald Cox

Stafford 610


Keystone Drain

sect 19 Lot 59A

• Drillers Log •

Depth	Description of Formation of Sediment	Remarks
0	10	Red Clay
10	25	Brown Clay
25	160	Dark Grey Rock
160	210	Light Grey Rock
210	240	Dark Grey Rock

DIAGRAM (NOT TO SCALE)

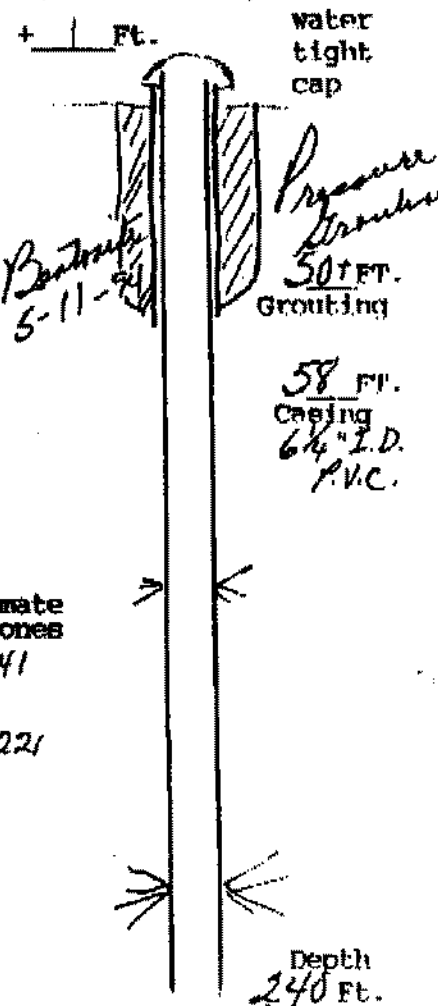

Approximate Water Zones
140 to 141
and
220 to 221

(Use additional Sheets if necessary)

I certify that the information contained here is true and that this well was installed and constructed in accordance with the permit and further that the well complies with all applicable state and local regulations, ordinances and laws.

Name JOHN L. DANIELSON, JR., INC.
 Address 4616 HOOD DRIVE
FREDERICKSBURG, VIRGINIA 22408
 Phone (703) 898-6025 / 898-9355

Drillers Signature John L. Danielson, Pres
 Date 5/1/54 Representing JOHN L. DANIELSON, JR., INC.

Virginia Contractors Licence Number CLASS A 2701 014084A II/II WVC