

**COMMONWEALTH OF VIRGINIA  
WATER WELL COMPLETION REPORT**

• BWCM No. \_\_\_\_\_

State Water Control Board  
P. O. Box 11143  
2111 North Hamilton St.  
Richmond, Va. 23290

(Certification of Completion/County Permit)

Tolson Construction  
2432 Mountain View Rd.  
Stafford, Va. 22554  
752-1010

County/City Stafford

County/City Stamp

• Virginia Plane Coordinates  
N \_\_\_\_\_  
E \_\_\_\_\_  
Latitude & Longitude  
N \_\_\_\_\_  
W \_\_\_\_\_

• Topo. Map No. 182B  
• Elevation \_\_\_\_\_ ft.  
• Formation \_\_\_\_\_  
• Lithology \_\_\_\_\_  
• River Basin \_\_\_\_\_  
• Province \_\_\_\_\_  
• Type Logs D. L.  
• Cuttings N. A.  
• Water Analysis \_\_\_\_\_  
• Aquifer Test \_\_\_\_\_

• Owner Rural Home Bldg  
• Well Designation or Number Reson Keyes  
Address \_\_\_\_\_  
Phone \_\_\_\_\_

• Drilling Contractor John L. Danielson, Jr., Inc.  
Address 4616 Hood Drive  
Fredericksburg, Virginia 22401  
Phone (703) 898-6025

SWCB Permit \_\_\_\_\_  
County Permit \_\_\_\_\_

Certification of inspecting official:  
This well does \_\_\_\_\_ does not \_\_\_\_\_  
meet code/tow requirements.  
S. \_\_\_\_\_  
Date \_\_\_\_\_

*For Office Use*  
20-44R

Tax Map I.D. No. \_\_\_\_\_  
Subdivision \_\_\_\_\_  
Section \_\_\_\_\_  
Block \_\_\_\_\_  
Lot \_\_\_\_\_  
Class Well: I \_\_\_\_\_, IIA \_\_\_\_\_  
IIB \_\_\_\_\_, IIIA \_\_\_\_\_, IIIB   
IIIC \_\_\_\_\_, IIID \_\_\_\_\_, IIIE \_\_\_\_\_

WELL LOCATION: .5 (feet/miles) W direction of intersection of 672 + 720  
and .1 (feet/miles) N (direction) of 720 (Fritter Lane)  
(If possible please include map showing location marked)  
Water rose 5 ft. in 30 min. @ time of installation  
24" I.D. casing holds 23.5 gal. of water per foot.  
Date started 9-20-88 • Date completed 9-20-88 Type rig Boring Rig

Approximate Drawdown \_\_\_\_\_ ft.

1. WELL DATA: New  Reworked \_\_\_\_\_ Deepened \_\_\_\_\_

• Total depth \_\_\_\_\_ 59 ft.  
• Depth to bedrock \_\_\_\_\_ ft. (on rock)  
• Hole size (Also include reamed zones)  
• 39 inches from 0 to 20 ft.  
• 29 inches from 20 to 59 ft.  
• \_\_\_\_\_ inches from \_\_\_\_\_ to \_\_\_\_\_ ft.

• Casing size (I.D.) and material  
• 24 inches from +1 to 59 ft.  
Material cement Concrete Casing  
Wt. per foot \_\_\_\_\_ or wall thickness \_\_\_\_\_ in.  
• \_\_\_\_\_ inches from \_\_\_\_\_ to \_\_\_\_\_ ft.  
Material \_\_\_\_\_  
Wt. per foot \_\_\_\_\_ or wall thickness \_\_\_\_\_ in.  
• \_\_\_\_\_ inches from \_\_\_\_\_ to \_\_\_\_\_ ft.  
Material \_\_\_\_\_  
Wt. per foot \_\_\_\_\_ or wall thickness \_\_\_\_\_ in.

• Screen size and mesh for each zone (where applicable)  
• \_\_\_\_\_ inches from \_\_\_\_\_ to \_\_\_\_\_ ft.  
• Mesh size \_\_\_\_\_ Type \_\_\_\_\_  
• \_\_\_\_\_ inches from \_\_\_\_\_ to \_\_\_\_\_ ft.  
• Mesh size \_\_\_\_\_ Type \_\_\_\_\_  
• \_\_\_\_\_ inches from \_\_\_\_\_ to \_\_\_\_\_ ft.  
• Mesh size \_\_\_\_\_ Type \_\_\_\_\_  
• \_\_\_\_\_ inches from \_\_\_\_\_ to \_\_\_\_\_ ft.  
• Mesh size \_\_\_\_\_ Type \_\_\_\_\_

• Gravel pack  
• From \_\_\_\_\_ to \_\_\_\_\_ ft.  
• From \_\_\_\_\_ to \_\_\_\_\_ ft.

• Grout  
• From \_\_\_\_\_ to \_\_\_\_\_ ft. Type \_\_\_\_\_  
• From \_\_\_\_\_ to \_\_\_\_\_ ft. Type \_\_\_\_\_

2. WATER DATA • Water temperature \_\_\_\_\_ of \_\_\_\_\_  
• Static water level (unpumped level-measured) \_\_\_\_\_ 35 ft.  
• Stabilized measured pumping water level \_\_\_\_\_ ft.  
• Stabilized yield \_\_\_\_\_ gpm after \_\_\_\_\_ hours  
Natural Flow: Yes \_\_\_\_\_ No \_\_\_\_\_, flow rate \_\_\_\_\_ gpm  
Comm: \_\_\_\_\_ on quality \_\_\_\_\_

3. WATER ZONES: From 35 To 45  
From \_\_\_\_\_ To \_\_\_\_\_ From \_\_\_\_\_ To \_\_\_\_\_  
From \_\_\_\_\_ To \_\_\_\_\_ From \_\_\_\_\_ To \_\_\_\_\_

4. USE DATA:  
Type of use: Drinking , Livestock Watering \_\_\_\_\_  
Irrigation \_\_\_\_\_, Food processing \_\_\_\_\_, Household   
Manufacturing \_\_\_\_\_, Fire safety \_\_\_\_\_, Cleaning \_\_\_\_\_  
Recreation \_\_\_\_\_, Aesthetic \_\_\_\_\_, Cooling or heating \_\_\_\_\_  
Injection \_\_\_\_\_, Other \_\_\_\_\_

• Type of facility: Domestic , Public water supply \_\_\_\_\_  
Public institution \_\_\_\_\_, Farm \_\_\_\_\_, Industry \_\_\_\_\_  
Commercial \_\_\_\_\_, Other \_\_\_\_\_

5. PUMP DATA: Type \_\_\_\_\_ • Rated H.P. \_\_\_\_\_  
• Intake depth \_\_\_\_\_ • Capacity \_\_\_\_\_ at \_\_\_\_\_ head


6. WELLHEAD: Type well seal \_\_\_\_\_  
Pressure tank \_\_\_\_\_ gal., Loc. \_\_\_\_\_  
Sample tap \_\_\_\_\_, Measurement port \_\_\_\_\_  
Well vent \_\_\_\_\_, Pressure relief valve \_\_\_\_\_  
Gate valve \_\_\_\_\_, Check valve (when required) \_\_\_\_\_  
Electrical disconnect switch on power supply \_\_\_\_\_

7. DISINFECTION: Well disinfected \_\_\_\_\_ yes \_\_\_\_\_ no \_\_\_\_\_  
Date \_\_\_\_\_, Disinfectant used \_\_\_\_\_  
Amount \_\_\_\_\_, Hours used \_\_\_\_\_

8. ABANDONMENT (where applicable) • yes \_\_\_\_\_ no \_\_\_\_\_  
Casing pulled yes \_\_\_\_\_ no \_\_\_\_\_ not applicable \_\_\_\_\_  
Plugging grout From \_\_\_\_\_ to \_\_\_\_\_ material \_\_\_\_\_  
Pump installation through Tolson Const

*Gravel backfill, Grouting*

Owner Talson Construction / Rural Home Blvd's  
Stafford 700

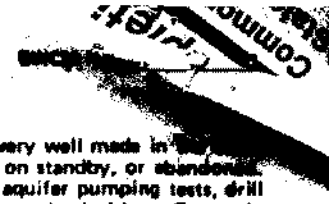

9. State law requires submitting to the Virginia State Water Control Board information about groundwater and wells for every well made in the state intended for water, or any other non-exempt well. This information must be submitted whether the well is completed, on standby, or abandoned. Information required includes: an accurately and completely prepared water well completion report, full data from any aquifer pumping tests, drill cuttings taken at ten foot intervals (unless exemption is secured), the results of any chemical analyses, and copies of any geophysical logs. Quarterly pumpage and use reports are required from owners of public supply and industrial wells. County or State permits to drill may be required in some parts of the state. Some counties require submission of a water well completion report. The Virginia State Health Department requires a water well completion report for public supply wells.

10. DRILLERS LOG (use additional Sheets if necessary)

10. DRILLERS LOG (use additional Sheets if necessary)			11.	12. DIAGRAM OF WELL CONSTRUCTION (with dimensions)
DEPTH (feet)		TYPE OF ROCK OR SOIL	REMARKS	Drilling Time (Min.)
From	To	(color, material, fossils, hardness, etc.)		

13. Well lot dedicated? \_\_\_\_\_ Size \_\_\_\_\_ ft. X \_\_\_\_\_ ft.; Well house? \_\_\_\_\_  
 Distance to nearest pollutant source \_\_\_\_\_ ft., Type \_\_\_\_\_  
 Distance to nearest property line \_\_\_\_\_ ft., Building \_\_\_\_\_ ft.

14. WATER SERVICE PIPE: Checked under \_\_\_\_\_ p.s.i. for \_\_\_\_\_  
 minutes. Pipe size \_\_\_\_\_ inches, Material \_\_\_\_\_  
 Installer \_\_\_\_\_  
 Date \_\_\_\_\_

15. I certify that the information contained herein is true and correct and that this well and/or system has been installed and constructed in accordance with the requirements for well construction as specified in compliance with appropriate county or independent city ordinances and the laws and rules of the Commonwealth of Virginia.

State Water Control Board Regional Offices

Valley Reg. Off.  
 116 North Main Street  
 P. O. Box 268  
 Bridgewater, Va. 22812  
 703-828-2595

Piedmont Reg. Off.  
 4010 West Broad Street  
 P. O. Box 6616  
 Richmond, Va. 23230  
 804-257-1006

Southwest Reg. Off.  
 408 East Main Street  
 P. O. Box 476  
 Abingdon, Va. 24210  
 703-628-5183

Tidewater Reg. Off.  
 287 Pembroke Office Park  
 Suite 310 Pembroke No. 2  
 Va. Beach, Va. 23462  
 804-499-8742

West Central Reg. Off.  
 Executive Park  
 5312 Peters Creek Road  
 Roanoke, Va. 24019  
 703-982-7432

Northern Virginia Reg. Off.  
 5515 Cherokee Avenue  
 Suite 404  
 Alexandria, Va. 22312  
 703-750-1111

Signature *Christy Daniels* (Well driller or authorized person) Date 9/26/88  
 License No. \_\_\_\_\_