


COMMONWEALTH OF VIRGINIA
WATER WELL COMPLETION REPORT

BWCM

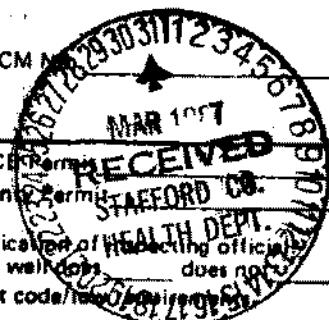

Who KNOWS (Certification of Completion/County Permit)

A & M Builders
Thetta's Clearance (Owner)
P.O. Box 219
Stafford, Va. 22554
639-4346

Water Control Board
Box 11143
1 North Hamilton St.
Richmond, Va. 23230

County/City Stafford

County/City Stamp

Virginia Plane Coordinates
N _____
E _____
Latitude & Longitude
N _____
W _____

Topo. Map No. _____
Elevation _____ ft.
Formation _____
Lithology _____
River Basin _____
Province _____
Type Logs D. L.
Cuttings N. A.
Water Analysis _____
Aquifer Test _____

Owner William Gallahan
Well Designation or Number _____
Address _____
Phone _____

Drilling Contractor John L. Danielson, Jr., Inc.
Address 4616 Hood Drive
Fredericksburg, Virginia 22401
Phone (703) 898-6025

Date _____
For Office Use 20-137

Tax Map I.D. No. 70-134
Subdivision _____
Section _____
Block _____
Lot _____
Class Well: I _____, IIA _____
IIB _____, IIIA _____, IIIB
IIIC _____, IIID _____, IIIE _____

WELL LOCATION: 1 (feet/miles) W. (direction) of intersection of 610 & 95
and 2/10 feet/miles S (direction) of 610
(If possible please include map showing location marked)
Water rose 2 ft. in 30 min. @ time of installation.
24" I.D. casing holds 23.5 gal. of water per foot.
Date started 1/5/87 Date completed 1/12/87 Cased Type rig Boring Rig

WELL DATA: New Reworked _____ Deepened _____

Total depth 38 ft.
Depth to bedrock On Rock ft.
Hole size (Also include reamed zones)
• 39 inches from _____ to _____ ft.
• 29 inches from _____ to _____ ft.
• _____ inches from _____ to _____ ft.

Casing size (I.D.) and material
• 24 inches from +1 to 38 ft. Material Concrete Casing
Wt. per foot _____ or wall thickness _____ in.
• _____ inches from _____ to _____ ft. Material _____
Wt. per foot _____ or wall thickness _____ in.
• _____ inches from _____ to _____ ft. Material _____
Wt. per foot _____ or wall thickness _____ in.

Screen size and mesh for each zone (where applicable)
• _____ inches from _____ to _____ ft. Mesh size _____ Type _____
• _____ inches from _____ to _____ ft. Mesh size _____ Type _____
Gravel pack
• From _____ to _____ ft.
• From _____ to _____ ft.

Grout
• From _____ to _____ ft. Type _____
• From _____ to _____ ft. Type _____

Approximate Drawdown 18 ft.

2. WATER DATA • Water temperature _____ °F
Static water level (unpumped level-measured) 12 ft.
Stabilized measured pumping water level 30 ft.
Stabilized yield approx 12 gpm after _____ hours
Natural Flow: Yes _____ No flow rate _____ gpm
Comment on quality _____

3. WATER ZONES: From 12 To 15
From _____ To _____ From _____ To _____
From _____ To _____ From _____ To _____

4. USE DATA:
Type of use: Drinking _____, Livestock Watering _____
Irrigation _____, Food processing _____, Household _____
Manufacturing _____, Fire safety _____, Cleaning _____
Recreation _____, Aesthetic _____, Cooling or heating _____
Injection _____, Other _____
Type of facility: Domestic _____, Public water supply _____
Public institution _____, Farm _____, Industry _____
Commercial _____, Other _____

5. PUMP DATA: Type _____ • Rated H.P. _____
Intake depth _____ • Capacity _____ at _____ head

6. WELLHEAD: Type well seal _____
Pressure tank _____ gal., Loc. _____
Sample tap _____, Measurement port _____
Well vent _____, Pressure relief valve _____
Gate valve _____, Check valve (when required) _____
Electrical disconnect switch on power supply _____

7. DISINFECTION: Well disinfected _____ yes _____ no _____
Date _____, Disinfectant used _____
Amount _____, Hours used _____

8. ABANDONMENT (where applicable) • yes _____ no _____
Casing pulled yes _____ no _____ not applicable _____
Plugging grout From _____ to _____ material _____
Pump installation through A & M Builders

Drinking &

