

**Commonwealth of Virginia
Uniform Water Well Completion Report**

Owner Randal A. Webb
 Address 232 Whitesoga Run
Stafford, Va. 22554
 Phone 434-659-1721 W. 240-3014
 Location Bald Eagle Hills Sectd Lot 20
Hulvey Drive

Tax Map ID 20H-2-20
 VDH Permit W-93-322
 VWCB Permit _____
 VWCB ID _____
 County STAFFORD

Well Classification IHA IIB IIC IV
 * Well Data *

General Information

Drilling Method Air Rotary Date Completed 7/16/94 Total Depth of Well 220
 Depth to Bedrock 12' Yield 80+ (GPM) Length of Test approx 1 Hr.
 Static Water Level approx 30' Stabilized Water Level approx 60' Natural Flow (Rate) _____
 Well Disinfected (Y or N) _____ Disinfectant Used _____ Amount Used _____

Casing
 From 1 To 60 From _____ To _____ From _____ To _____
 Size 4" Material P.V.C. Size _____ Material _____ Size _____ Material _____
 Weight/Schedule SDR 27 Weight/Schedule _____ Weight/Schedule _____

Gravel Pack
 From _____ To _____ From _____ To _____ From _____ To _____
 Hole size 10" from 0 to 60 ft. 68" from 60 to 220 ft. " from _____ to _____ ft.
 Grout
 From 0 To 50+ From _____ To _____ From _____ To _____
 Bore Hole Size 10" Bore Hole Size _____ Bore Hole Size _____
 Type Bentonite Type _____ Type _____
 Method Pressure Grouting Method _____ Method _____

Water Zones or Screened Intervals
 From 140 To 141 From _____ To _____ From _____ To _____
 Mesh Size _____ Diam _____ Mesh Size _____ Diam _____ Mesh Size _____ Diam _____
 From 210 To 211 From _____ To _____ From _____ To _____
 Mesh Size _____ Diam _____ Mesh Size _____ Diam _____ Mesh Size _____ Diam _____

* Use Data *

Private Well: Domestic Agricultural _____ Industrial _____ Monitoring _____
 Public Well: Community _____ Non Community _____

* Abandonment Information *

Bored or Dug Wells

Casing Removed, Y or N? _____
 If Y, Depth to which casing was removed: _____
 Depth and Type of Fill: _____
 Source of Fill _____
 Bentonite Plugs: From _____ to _____ From _____ to _____

Wells other than Bored Wells

Casing removed, Y or N? _____
 Depth to which casing was removed: _____
 Applicable, depth(s), and type of gravel sand fill: _____
 Source of gravel or sand: _____
 Cement: From _____ to _____ From _____ to _____


Method of permanently marking location:
 Installed watertight top
 Suggest setting pump @ approx. 80 Ft.



WYATT

Randall A. Webb
Bald Eagle #20
Stafford
Hulvey Drive
Drillers Log

Depth	Description of Formation or Sediment	Remarks
0	12	Red Clay
12	70	Brown Shale
70	220	Light Grey Granite

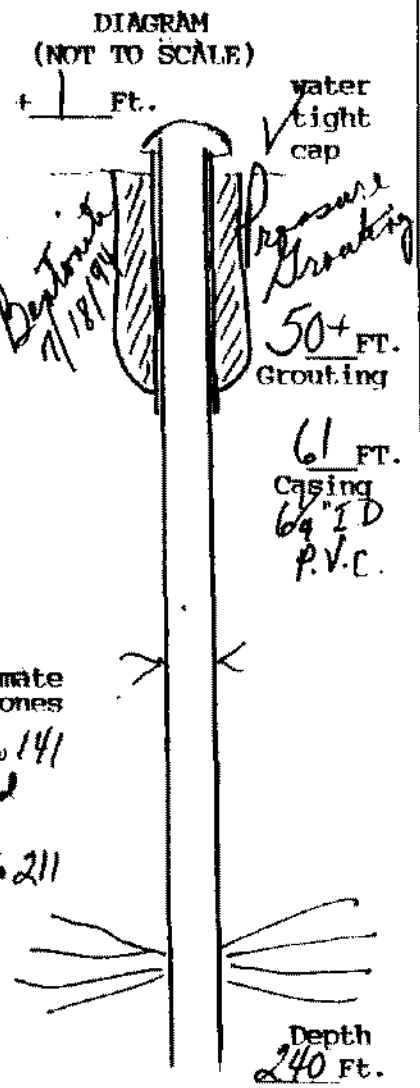

Approximate Water Zones
140 to 141
and
210 to 211

(User additional Sheets if necessary)

I certify that the information contained here is true and that this well was installed and constructed in accordance with the permit and further that the well complies with all applicable state and local regulations, ordinances and laws.

Name JOHN L. DANIELSON, JR., INC.
 Address 4616 HOOD DRIVE
FREDERICKSBURG, VIRGINIA 22408
 Phone (703) 898-6025 / 898-9355

Drillers Signature John L. Danielson, Pres
 Date 7/18/99 Representing JOHN L. DANIELSON, JR., INC.

Virginia Contractors License Number CLASS A 2701 014084A II/II WVC