

703 361 4513
COMMONWEALTH OF VIRGINIA
WATER WELL COMPLETION REPORT
Certification of Completion/County Permit
Classic Concepts

703 361 4513 P.02
 • BWCM No. _____

_____ Street
 _____ Virginia 23230

County/City STAFFORD CO.
 County/City Stamp _____

SWCB Permit _____
 County Permit _____
 Certification of inspecting official:
 This well does _____ does not _____
 meet code/flow requirements.
 S. _____
 Date _____
 For Office Use

• Virginia Plane Coordinates
 _____ N
 _____ E
 • Latitude & Longitude
 _____ N
 _____ W
 • Topo. Map No. _____
 • Elevation _____
 • Formation _____
 • Lithology _____
 • River Basin _____
 • Province _____
 • Type logs _____
 • Cuttings _____
 • Water Analysis _____
 • Aquifer Test _____

• Owner Classic Concepts
 • Well Designation or Number _____
 Address _____
 Phone 791-2885

• Drilling Contractor: Northern Virginia Drilling
 Address 7256 Foster Lane
Nokesville, VA 22123
 Phone: (703) 361-6959

SWP-96-190
 Tax Map I.D. No. 22-16-1
 Subdivision Valley Ridge
 Section _____
 Block _____
 Lot 1
 Class Well I _____ IA _____
 IIB _____ IIA _____ IIB
 IIC _____ IID _____ IIE _____

WELL LOCATION: _____ (feet/miles _____ direction) of _____
 and _____ (feet/miles _____ direction) of _____
 (if possible please include map showing location marked)
 Date started 1-9-97 • Date completed 1-10-97 Type rig AIR ROTARY

1. WELL DATA: New Reworked _____ Deepened _____

- Total depth 240 ft.
- Depth to bedrock 50 ft.
- Hole size (Also include reamed zones)
 - 10 inches from 0 to 62 1/2 ft.
 - 6 1/8 inches from 62 1/2 to 210 ft.
 - _____ inches from _____ to _____ ft.
- Casing size (I.D.) and material
 - 6 1/8 inches from 0 to 64 ft.
 Material STEEL
 Wt. per foot 13 or wall thickness .188 in.
 - _____ inches from _____ to _____ ft.
 Material _____
 Wt. per foot _____ or wall thickness _____ in.
 - _____ inches from _____ to _____ ft.
 Material _____
 Wt. per foot _____ or wall thickness _____ in.
- Screen size and mesh for each zone (where applicable)
 - 1 1/2 inches from 180 to 140 ft.
 - Mesh size SOLID Type PVC
 - 4 1/2 inches from 140 to 100 ft.
 - Mesh size 20 Type PVC
 - 4 1/2 inches from 100 to 80 ft.
 - Mesh size SOLID Type PVC
 - 4 1/2 inches from 80 to 40 ft.
 - Mesh size 30 Type PVC
- Gravel Pack
 - From _____ to _____ ft.
 - From _____ to _____ ft.
- Grout
 - From 55 to 0 ft., Type Cement
 - From 62 1/2 to 55 ft., Type Rock Cuttings

WATER DATA - Water Temperature _____

- Static water level (unpumped level-measured) 70
- Stabilized measured pumping water level _____
- Stabilized yield 15 gpm after _____ hours
- Natural Flow: Yes _____ No flow rate: _____ gpm
- Comment on quality Sediment Present

3. WATER ZONES: From 85 To 90
 From 110 To 114 From _____ To _____
 From _____ To _____ From _____ To _____

USE DATA:
 Type of use: Drinking Livestock Watering _____
 Irrigation _____ Food processing _____ Household
 Manufacturing _____ Fire Safety _____ Cleaning _____
 Recreation _____ Aesthetic _____ Cooling or heating _____
 Injection _____ Other _____
 • Type of facility Domestic Public water supply _____
 Public Institution _____ Farm _____ Industry _____
 Commercial _____ Other _____

5. PUMP DATA: Type _____ • Rated H.P. _____
 • Intake depth _____ • Capacity _____ at _____ head

6. WELLHEAD: Type well seal _____
 Pressure Tank _____ gal. Loc _____
 Sample tap _____ Measurement port _____
 Well vent _____ Pressure relief valve _____
 Gate valve _____ Check valve (when required) _____
 Electrical disconnect switch on power supply _____

7. DISINFECTION: Well disinfected _____ Yes _____ No _____
 Date _____ Disinfectant used _____
 Amount _____ Hours used _____

8. ABANDONMENT (where applicable) • Yes _____ No _____
 Casing pulled Yes _____ No _____ Not Applicable _____
 Plugging grout From _____ to _____ material _____

requires submitting to the Virginia State Water Control Board information about groundwater and wells for every well made in the state for water, or any other non-exempt well. This information must be submitted whether the well is completed, on standby, or abandoned. Information required includes: an accurately and completely prepared water well completion report, full data from any aquifer pumping tests, drill cuttings taken at ten foot intervals (unless exemption is secured), the results of any chemical analysis, and copies of any geophysical logs. Quarterly pumpage and use reports are required from owners of public supply and industrial wells. County or State permits to drill may be required in some parts of the state. Some counties require submission of a water well completion report. The Virginia State Health Department requires a water well completion report for public supply wells.


10. DRILLERS LOG (use additional sheets if necessary)

DEPTH (feet)		TYPE OF ROCK OR SOIL <small>(color, material, fossils, hardness etc.)</small>	REMARKS <small>(water, casing, casing, broken, core, shot, etc.)</small>
From	To		
0	50	OVERBURDEN	WELL CASING AT 90 FT WILL INSTALL SCREEN & RISE PIPE TO FIX PROBLEM.
50	75	SANDSTONE	
75	90	BROKEN GRAVEL & WATER	
90	240	MARINE CLAY & BLUE SAND	

11.

Drilling Time (Min.)

12. DIAGRAM OF WELL CONSTRUCTION (with dimensions)

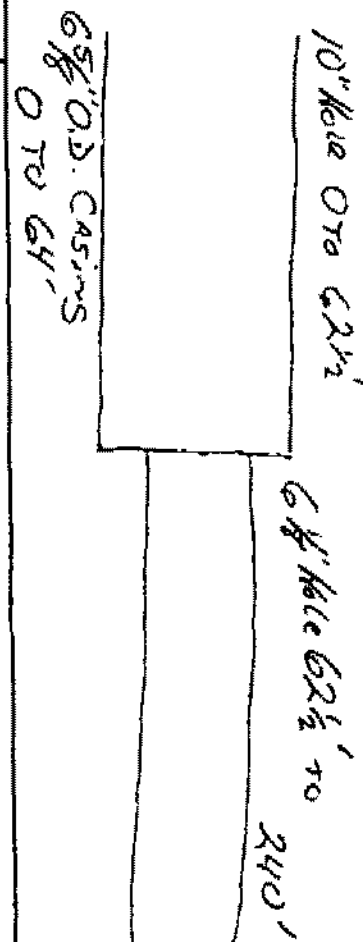

State Water Control Board Regional Offices

Valley Reg. Off.
116 North Main Street
P.O. Box 268
Bridgewater, Va. 22612
703-828-2595

Piedmont Reg. Off.
4010 West Broad Street
P.O. Box 6616
Richmond, Va. 23230
804-257-1006

Southwest Reg. Off.
408 East Main Street
P.O. Box 476
Abingdon, Va. 24210
703-828-5183

Tidewater Reg. Off.
287 Pembroke Office Park
Suite 310 Pembroke No. 2
Va. Beach, Va. 23462
804-499-8742

West Central Reg. Off.
Executive Park
5312 Peters creek Road
Roanoke, Va. 24019
703-982-7432

Northern Virginia Reg. Off.
5515 Cherokee Avenue
Suite 404
Alexandria, Va. 22312
703-750-9111

13. Well lot dedicated? _____: Size _____ ft. x _____ ft. Well house? _____
Distance to nearest pollutant source _____ ft., Type _____
Distance to nearest property line _____ ft., Building _____ ft.

14. WATER SERVICE PIPE: Checked under _____ P.S.I. for _____
minutes. Pipe size _____ inches, Material _____
Installer _____
Date _____

15. I certify that the information contained herein is true and correct and that this well and/or system has been installed and constructed in accordance with the requirements for well construction as specified in compliance with appropriate county or independent city ordinances and the laws and rules of the Commonwealth of Virginia.

Signature _____ (Seal) Date 1-10-97
(Well owner or authorized person)

License No. 015640