

Classic Builders, Inc  
13467 Hatfield Drive  
Manassas, Va. 22111  
1-703-791-2885 F-791-4913

Commonwealth of Virginia  
Uniform Water Well Completion Report

Owner Classic Concept Builders Inc / For Sale  
Address 13467 Hatfield Drive  
Manassas, Va. 22111  
Phone 1-703-791-2885  
Location Valley Ridge, Lot F / off # 611  
Wine water  
Well Classification IIIA IIIB ✓ IIIC IV  
\* Well Data \*

22-16-F  
Tax Map ID 22-16-F  
VDH Permit SWP-96-191  
VWCB Permit \_\_\_\_\_  
VWCB ID \_\_\_\_\_  
County STAFFORD  
6/18/96 Ashton B Wright  
DCI/JO

General Information

Drilling Method Air Rotary  
Depth to Bedrock \_\_\_\_\_  
Static Water Level 100'  
Well Disinfected (Y or N) \_\_\_\_\_

Date Completed 9/10/96  
Yield 20 (GPM)  
Stabilized Water Level 180  
Disinfectant Used \_\_\_\_\_

Total Depth of Well 258  
Length of Test approx 2 Hrs.  
Natural Flow (Rate) \_\_\_\_\_  
Amount Used \_\_\_\_\_

Casing

From +1 To 80  
Size 6 1/4 Material P.V.C.  
Weight/Schedule S.D.R. 27

From 80 To 100  
Size 6 3/8 Material P.V.C.  
Weight/Schedule S.D.R. 21

From 75' To 238'  
Size 4" Material P.V.C.  
Weight/Schedule Schedule 40

Gravel Pack

From \_\_\_\_\_ To \_\_\_\_\_

From \_\_\_\_\_ To \_\_\_\_\_

From \_\_\_\_\_ To \_\_\_\_\_

Hole size

10" from 0 to 55 ft.

8" from 55 to 100 ft.

6" from 100 to 258 ft.

Grout

From 0 To 50'  
Bore Hole Size 10"  
Type Bentonite  
Method Pressure Grouting

From \_\_\_\_\_ To \_\_\_\_\_  
Bore Hole Size \_\_\_\_\_  
Type \_\_\_\_\_  
Method \_\_\_\_\_

From \_\_\_\_\_ To \_\_\_\_\_  
Bore Hole Size \_\_\_\_\_  
Type \_\_\_\_\_  
Method \_\_\_\_\_

Water Zones or Screened Intervals

From 238 To 258  
Mesh Size #20 Diam 4" (P.V.C.)  
From \_\_\_\_\_ To \_\_\_\_\_  
Mesh Size \_\_\_\_\_ Diam \_\_\_\_\_

From 220 To 258  
Mesh Size \_\_\_\_\_ Diam \_\_\_\_\_  
From \_\_\_\_\_ To \_\_\_\_\_  
Mesh Size \_\_\_\_\_ Diam \_\_\_\_\_

From \_\_\_\_\_ To \_\_\_\_\_  
Mesh Size \_\_\_\_\_ Diam \_\_\_\_\_  
From \_\_\_\_\_ To \_\_\_\_\_  
Mesh Size \_\_\_\_\_ Diam \_\_\_\_\_

\* Use Data \*

Private Well: Domestic  Agricultural \_\_\_\_\_ Industrial \_\_\_\_\_ Monitoring \_\_\_\_\_  
Public Well: Community \_\_\_\_\_ Non Community \_\_\_\_\_

\* Abandonment Information \*

Bored or Dug Wells

Casing Removed, Y or N? \_\_\_\_\_  
If Y, Depth to which casing was removed: \_\_\_\_\_  
Depth and Type of Fill: \_\_\_\_\_  
Source of Fill \_\_\_\_\_  
Bentonite Plugs: From \_\_\_\_\_ to \_\_\_\_\_ From \_\_\_\_\_ to \_\_\_\_\_

Wells other than Bored Wells

Casing removed, Y or N? \_\_\_\_\_  
Depth to which casing was removed: \_\_\_\_\_  
Applicable, depth(s), and type of gravel/sand fill: \_\_\_\_\_  
Source of gravel or sand: \_\_\_\_\_  
Cement: From \_\_\_\_\_ to \_\_\_\_\_ From \_\_\_\_\_ to \_\_\_\_\_

Method of permanently marking location: \_\_\_\_\_


Installed watertight top  
Suggest setting pump @ approx. 220 ft.  
you will encounter 4" casing @ approx 75 ft.  
Suggest keeping centralizers / torque arresters out of 4" casing.

Classic Concepts Builders Inc  
Valley Ridge # F  
Stafford  
 off 611

- Widewater  
 Drillers Log

Completion State

Depth	Description of Formation or Sediment	Remarks
0	1	Topsoil
1	15	yellow sandy clay
15	40	yellow sand & gravel
40	85	Black sand
85	110	Grey clay
110	130	Sandy grey clay
130	180	Grey & Brown Clay
180	220	Grey Sandy Clay
220	254	Grey sand - water zone
254	258	Grey clay

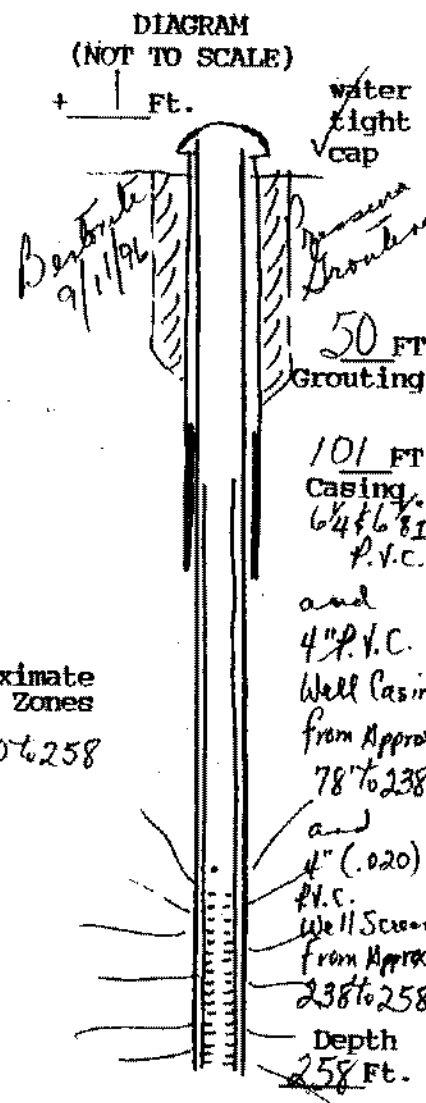

Approximate Water Zones  
 220 to 258



(Use additional Sheets if necessary)

I certify that the information contained here is true and that this well was installed and constructed in accordance with the permit and further that the well complies with all applicable state and local regulations, ordinances and laws.

Name JOHN L. DANIELSON, JR., INC.  
 Address 4616 HOOD DRIVE  
FREDERICKSBURG, VIRGINIA 22408  
 Phone 540 (893) 898-6025 / 898-9355

Drillers Signature [Signature]  
 Date 9/12/96 Representing JOHN L. DANIELSON, JR., INC.

Virginia Contractors License Number CLASS A 2701 014084A II/II WVC