

Melvin
Sunshine Home Builders
PO Box 840
Harrisonville, VA
659-1113 F

Commonwealth of Virginia
Uniform Water Well Completion Report

2E-3

Owner Sunshine Home Builders / F&S
Address P.O. Box 840
Harrisonville, VA
Phone 659-1113
Location Sunshine Tract # 3

Tax Map ID 22-92-3
VDH Permit SWP-98-229
VWCB Permit _____
VWCB ID _____
County Stafford
4/17/98 Rob [unclear]
CRG

Well Classification IIIA _____ IIIB IIIC _____ IV _____
* Well Data *

General Information

Drilling Method Mud Rotary
Depth to Bedrock _____
Static Water Level 120
Well Disinfected (Y or N) _____

Date Completed 8/5/98
Yield 20 (GPM)
Stabilized Water Level 140
Disinfectant Used _____

Total Depth of Well 245
Length of Test approx 2 Hrs
Natural Flow (Rate) _____
Amount Used _____

Casing

From 1 To 205
Size 4 1/2" Material PVC
Weight/Schedule SDR 17

From 225 To 245
Size 4 1/2" Material PVC
Weight/Schedule SDR 17

From _____ To _____
Size _____ Material _____
Weight/Schedule _____

Gravel Pack

From 60 To 245

From _____ To _____

From _____ To _____

Hole size

" from _____ to _____ ft.

" from _____ to _____ ft.

" from _____ to _____ ft.

Grout

From 0 To 60 +
Bore Hole Size 7 1/8" 8/5
Type Bentonite
Method Pressure Grouting

From _____ To _____
Bore Hole Size _____
Type _____
Method _____

From _____ To _____
Bore Hole Size _____
Type _____
Method _____

Water Zones or Screened Intervals

From 205 To 225
Mesh Size 20 Diam 4 1/2" (PVC)
From _____ To _____
Mesh Size _____ Diam _____

approx water zone
From 205 To 225
Mesh Size _____ Diam _____
From _____ To _____
Mesh Size _____ Diam _____

From _____ To _____
Mesh Size _____ Diam _____
From _____ To _____
Mesh Size _____ Diam _____

* Use Data *

Private Well: Domestic Agricultural _____ Industrial _____ Monitoring _____
Public Well: Community _____ Non Community _____

3/4 H.P. 10 G.P.M. STA-Rite Submers
Stainless Steel

* Abandonment Information *

Bored or Dug Wells

Casing Removed, Y or N? _____
If Y, Depth to which casing was removed: _____
Depth and Type of Fill: _____
Source of Fill _____
Bentonite Plugs: From _____ to _____ From _____ to _____

Wells other than Bored Wells

Casing removed, Y or N? _____
Depth to which casing was removed: _____
Applicable, depth(s), and type of gravel/sand fill: _____
Source of gravel or sand: _____
Cement: From _____ to _____ From _____ to _____

Method of permanently marking location:

Installed watertight top
Suggest setting pump @ approx. 160 ft.


Location
Super Horse Brides =
Superior Unit #3
Stafford
 off # 611

* Drillers Log *

Depth Description of Formation or Sediment Remarks

| | | |
|-----|-----|------------------------|
| 5 | 10 | Red Clay |
| 10 | 130 | Sand & Gravel |
| 130 | 170 | Grey Clay |
| 170 | 205 | Sandy Grey Clay |
| 205 | 225 | Grey Sand - water zone |
| 225 | 245 | Red Clay |

DIAGRAM
(NOT TO SCALE)

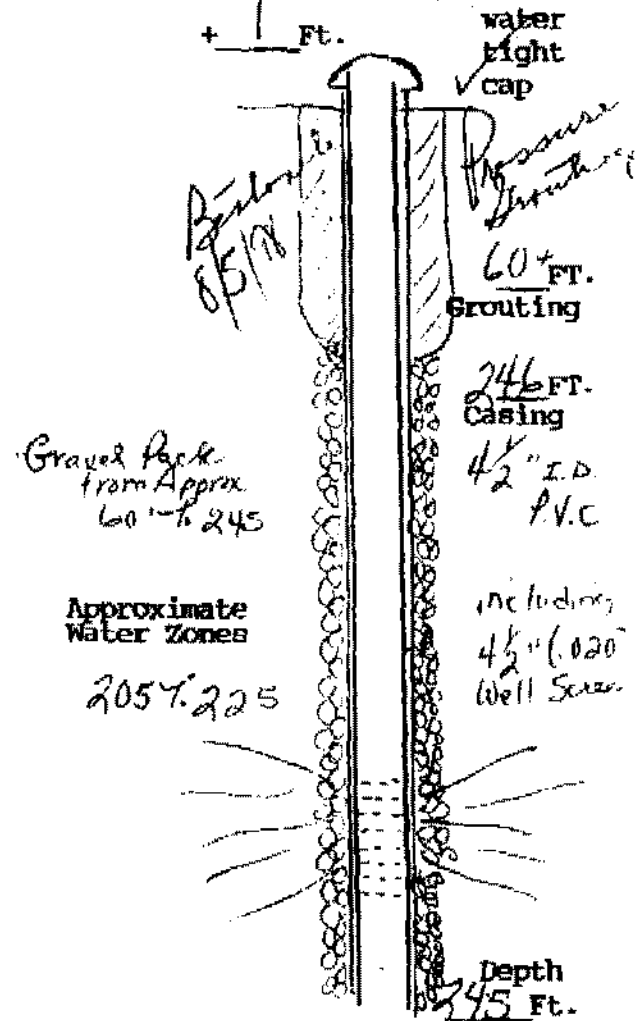

(Use additional Sheets if necessary)

I certify that the information contained here is true and that this well was installed and constructed in accordance with the permit and further that the well complies with all applicable state and local regulations, ordinances and laws.

Name JOHN L. DANIELSON, JR., INC.
 Address 4616 HOOD DRIVE
FREDERICKSBURG, VIRGINIA 22408
 Phone 540 (898) 898-6025 / 898-9355

Drillers Signature [Signature]
 Date 8/5/78 Representing JOHN L. DANIELSON, JR., INC.

Virginia Contractors License Number CLASS A 2701 014084A H/H WVC