

C. McMillan
 Sunshine Home Builders
 P.O. Box 840
 Harrisonville, Va. 22463 Commonwealth of Virginia
 559-1113 720-8196 Uniform Water Well Completion Report

Owner Sunshine Home Builders
 Address P.O. Box 840
Harrisonville, Va. 22463
 Phone 559-1113
 Location Shenandoah - Shen + P - 6011

Tax Map ID 22-92-2
 VDH Permit SWP-98-230
 VWCB Permit _____
 VWCB ID _____
 County Stafford
4/9/98 Rob Snyder
CRG

Well Classification IIIA _____ IIIB IIIC _____ IV _____
 * Well Data *

General Information
 Drilling Method Mud Rotary
 Depth to Bedrock _____
 Static Water Level 130'
 Well Disinfected (Y or N) _____

Date Completed 8/6/98
 Yield 20 GPM (GPM)
 Stabilized Water Level 140'
 Disinfectant Used _____

Total Depth of Well 247
 Length of Test Approx 3 Hrs
 Natural Flow (Rate) _____
 Amount Used _____

Casing
 From 7 1/2 To 220
 Size 4 1/2 Material PVC
 Weight/Schedule _____

From 240 To 247
 Size 4 1/2 Material PVC
 Weight/Schedule _____

From _____ To _____
 Size _____ Material _____
 Weight/Schedule _____

Gravel Pack
 From 60 To 247

From _____ To _____

From _____ To _____

Hole size
 " from _____ to _____ ft.

" from _____ to _____ ft.

" from _____ to _____ ft.

Grout
 From 0 To 60+ 8/15/98
 Bore Hole Size 7/8
 Type Bentonite
 Method Pressure Grouting

From 220 To 240
 Bore Hole Size _____
 Type _____
 Method _____

From _____ To _____
 Bore Hole Size _____
 Type _____
 Method _____

Water Zones or Screened Intervals
 From 220 To 240
 Mesh Size 20 Diam 4 1/2 (PVC)
 From _____ To _____
 Mesh Size _____ Diam _____

approx water zone
 From _____ To _____
 Mesh Size _____ Diam _____
 From _____ To _____
 Mesh Size _____ Diam _____

From _____ To _____
 Mesh Size _____ Diam _____
 From _____ To _____
 Mesh Size _____ Diam _____

* Use Data *

Private Well: Domestic Agricultural _____ Industrial _____ Monitoring _____
 Public Well: Community _____ Non Community _____

11/1/98
3/4" P. 16 GPM STA-IRK
STAINLESS STEEL Sub.

* Abandonment Information *

Bored or Dug Wells
 Casing Removed, Y or N? _____
 If Y, Depth to which casing was removed: _____
 Depth and Type of Fill: _____
 Source of Fill _____
 Bentonite Plugs: From _____ to _____ From _____ to _____


Wells other than Bored Wells
 Casing removed, Y or N? _____
 Depth to which casing was removed: _____
 Applicable, depth(s), and type of grave/sand fill: _____
 Source of gravel or sand: _____
 Cement: From _____ to _____ From _____ to _____

Method of permanently marking location:
 Installed watertight top
 Suggest setting pump @ approx. 160 ft.

*William
Hanson Home Builders
Sunshine View #2
Stafford
#611*

* Drillers Log *

Depth	Description of Formation or Sediment
0	10 Red Clay
10	150 Sand & Gravel
150	170 Grey clay
170	220 Sandy Grey Clay
220	240 Grey Sand - water zone
240	247 Red Clay

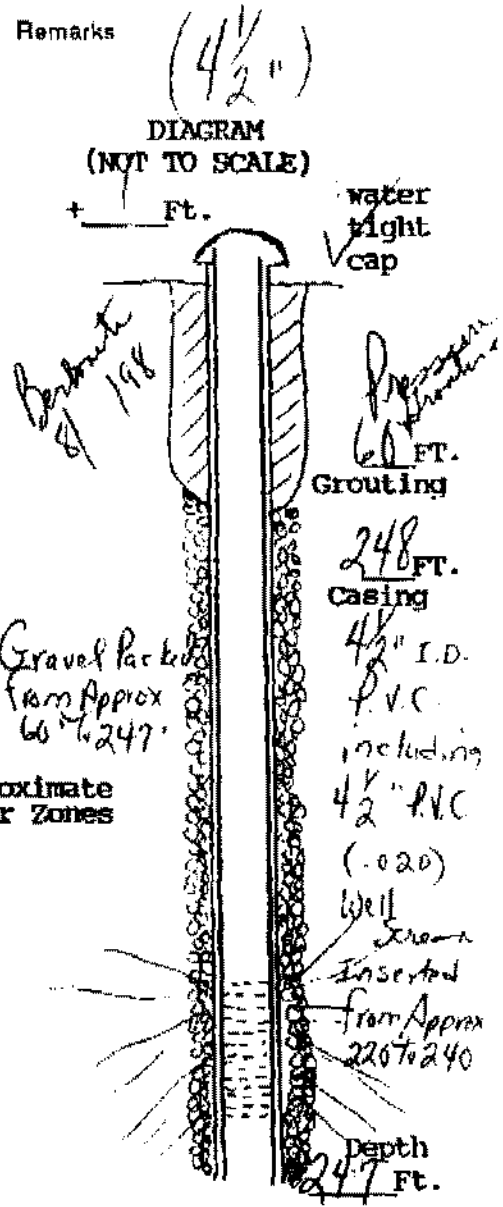

(Use additional Sheets if necessary)

I certify that the information contained here is true and that this well was installed and constructed in accordance with the permit and further that the well complies with all applicable state and local regulations, ordinances and laws.

Name JOHN L. DANIELSON, JR., INC.
 Address 4616 HOOD DRIVE
FREDERICKSBURG, VIRGINIA 22408
 Phone 540 (222) 898-6025 / 898-9255

Drillers Signature *John L. Danielson, Jr. Pres.*
 Date 8/2/98 Representing JOHN L. DANIELSON, JR., INC.

Virginia Contractors License Number CLASS A 2701 014084A H/H RWC