

General Contractor  
107 Leavilla Road  
Fredericksburg, VA  
898-5330/313-6262/898-3988

Commonwealth of Virginia  
Uniform Water Well Completion Report

Owner Antoine & Mike Powell / For Sale  
Address P.O. Box 122  
Stafford, Va. 22554  
Phone 669-3126  
Location Kings Grant # 120 (Katy, Megan Way)  
183A  
Well Classification IIIA IIIB IIIC IV  
2 1/2 M. South of 1/2 M. East of 615 Well Data \*

Tax Map ID 24A-120  
VDH Permit 65-92-384  
VWCB Permit \_\_\_\_\_  
VWCB ID \_\_\_\_\_  
County Stafford  
12/29/92 Rob Snydman  
14/29/92 T + Thompson

General Information

Drilling Method Air Rotary  
Depth to Bedrock 35  
Static Water Level 30  
Well Disinfected (Y or N) \_\_\_\_\_

Date Completed 5/9/94  
Yield 60 (GPM)  
Stabilized Water Level 80  
Disinfectant Used \_\_\_\_\_

Total Depth of Well 240  
Length of Test 1 Hr  
Natural Flow (Rate) \_\_\_\_\_  
Amount Used \_\_\_\_\_

Casing

From 0 To 52  
Size 6 1/4 Material PVC  
Weight/Schedule SUR 27

From \_\_\_\_\_ To \_\_\_\_\_  
Size \_\_\_\_\_ Material \_\_\_\_\_  
Weight/Schedule \_\_\_\_\_

From \_\_\_\_\_ To \_\_\_\_\_  
Size \_\_\_\_\_ Material \_\_\_\_\_  
Weight/Schedule \_\_\_\_\_

Gravel Pack

From \_\_\_\_\_ To \_\_\_\_\_

From \_\_\_\_\_ To \_\_\_\_\_

From \_\_\_\_\_ To \_\_\_\_\_

Hole size

10" from 0 to 52 ft.

6 1/8" from 52 to 240 ft.

\_\_\_\_\_ " from \_\_\_\_\_ to \_\_\_\_\_ ft.

Grout

From 0 To 50+  
Bore Hole Size 10" 5/10/94  
Type Bentonite  
Method Pressure Grouting

From \_\_\_\_\_ To \_\_\_\_\_  
Bore Hole Size \_\_\_\_\_  
Type \_\_\_\_\_  
Method \_\_\_\_\_

From \_\_\_\_\_ To \_\_\_\_\_  
Bore Hole Size \_\_\_\_\_  
Type \_\_\_\_\_  
Method \_\_\_\_\_

Water Zones or Screened Intervals

From 160 To 161  
Mesh Size \_\_\_\_\_ Diam \_\_\_\_\_  
From 220 To 221  
Mesh Size \_\_\_\_\_ Diam \_\_\_\_\_

From \_\_\_\_\_ To \_\_\_\_\_  
Mesh Size \_\_\_\_\_ Diam \_\_\_\_\_  
From \_\_\_\_\_ To \_\_\_\_\_  
Mesh Size \_\_\_\_\_ Diam \_\_\_\_\_

From \_\_\_\_\_ To \_\_\_\_\_  
Mesh Size \_\_\_\_\_ Diam \_\_\_\_\_  
From \_\_\_\_\_ To \_\_\_\_\_  
Mesh Size \_\_\_\_\_ Diam \_\_\_\_\_

\* Use Data \*

Private Well: Domestic  Agricultural \_\_\_\_\_ Industrial \_\_\_\_\_ Monitoring \_\_\_\_\_  
Public Well: Community \_\_\_\_\_ Non Community \_\_\_\_\_

\* Abandonment Information \*

Bored or Dug Wells

Casing Removed, Y or N? \_\_\_\_\_  
If Y, Depth to which casing was removed: \_\_\_\_\_  
Depth and Type of Fill: \_\_\_\_\_  
Source of Fill \_\_\_\_\_  
Bentonite Plugs: From \_\_\_\_\_ to \_\_\_\_\_ From \_\_\_\_\_ to \_\_\_\_\_

Wells other than Bored Wells

Casing removed, Y or N? \_\_\_\_\_  
Depth to which casing was removed: \_\_\_\_\_  
Applicable, depth(s), and type of gravel/sand fill: \_\_\_\_\_  
Source of gravel or sand: \_\_\_\_\_  
Cement: From \_\_\_\_\_ to \_\_\_\_\_ From \_\_\_\_\_ to \_\_\_\_\_

Method of permanently marking location:

Installed watertight top  
Suggest setting pump @ approx. 100 ft.


L. Jone Wilson / L.J.W. General Contractor  
For Sale  
Keige Grant # 120  
 - Lady Megan Way -  
 Drillers Log

ALBERT  
 J.C. OLDE GREENWICH DRIVE  
 FREDERICKSBURG, VA

Depth Description of Formation of Sediment Remarks

0	10	Red Clay
10	35	Brown Clay
35	240	Light Grey Rock

DIAGRAM  
(NOT TO SCALE)

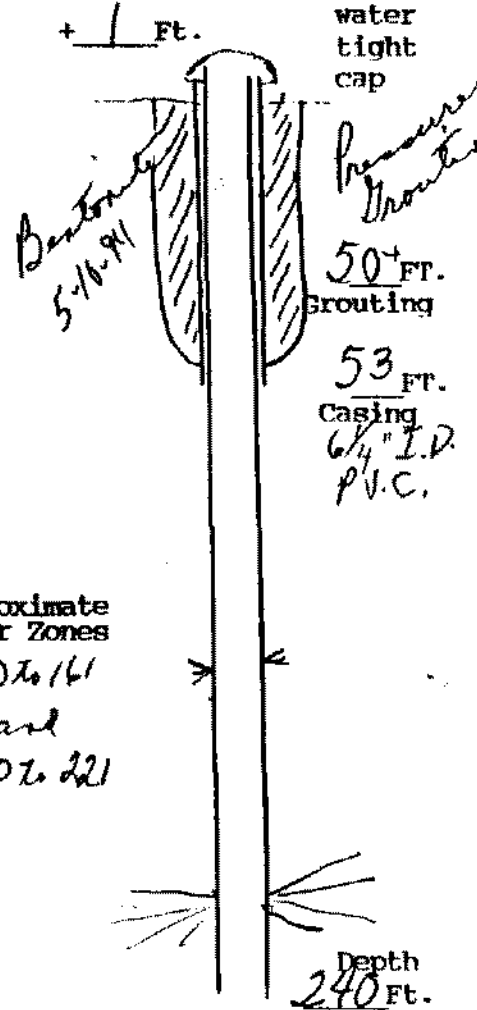

Approximate  
Water Zones  
160 to 161  
and  
220 to 221

(User additional Sheets if necessary)

I certify that the information contained here is true and that this well was installed and constructed in accordance with the permit and further that the well complies with all applicable state and local regulations, ordinances and laws.

Name JOHN L. DANIELSON, JR., INC.  
 Address 4616 HOOD DRIVE  
FREDERICKSBURG, VIRGINIA 22408  
 Phone (703) 898-6025 / 898-9355

Drillers Signature John L. Danielson, Pres  
 Date 5/10/94 Representing JOHN L. DANIELSON, JR., INC.

Virginia Contractors License Number CLASS A 2701 014084A H/H WVC