

COMMONWEALTH OF VIRGINIA

WATER WELL COMPLETION REPORT

•BWCM No. _____

(Certification of Completion/County Permit)

State Water Control Board
P. O. Box 11143
2111 North Hamilton St.
Richmond, Va. 23230

County/City

Stafford

County/City Stamp

SWCB Permit _____
County Permit _____
Certification of inspecting official:
This well does _____ does not _____
meet code/low requirements.
S. _____
Date _____

For Office Use

24A-4A-52

Tax Map I.D. No. *WS-93-133*
Subdivision *King Henry Ct*
Section _____
Block _____
Lot *52*
Class Well: I _____ IIA _____
IIB _____ IIIA _____ IIIB
IIIC _____ IIID _____ IIIE _____

• Virginia Plane Coordinates
_____ N
_____ E
Latitude & Longitude
_____ N
_____ W
• Topo. Map No. _____
• Elevation _____ ft.
• Formation _____
• Lithology _____
• River Basin _____
• Province _____
• Type Logs _____
• Cuttings _____
• Water Analysis _____
• Aquifer Test _____

• Owner *Robert Saunders*
• Well Designation or Number *24A-4A-52*
Address *King Henry Ct.*
Phone _____
• Drilling Contractor *R. L. Curtis Well Co*
Address *Mt. ... Box 165*
Bealton Va
Phone *439-8377*

WELL LOCATION: _____ (feet/miles _____ direction) of _____
and _____ (feet/miles _____) (direction) of _____
(If possible please include map showing location marked)

Date started *11/22/93* • Date completed *11/22/93* Type rig *air*

1. WELL DATA: New Reworked _____ Deepened _____

• Total depth *165* ft.

• Depth to bedrock *75* ft.

• Hole size (Also include reamed zones)

• *10* inches from *0* to *57* ft.

• *6* inches from *57* to *165* ft.

• _____ inches from _____ to _____ ft.

• Casing size (I.D.) and material

• *6* inches from _____ to *57* ft.

Material *0 to 40 steel*

Wt. per foot *13* or wall thickness *188* in.

• _____ inches from _____ to _____ ft.

Material *20 to 57 Pledston*

Wt. per foot _____ or wall thickness _____ in.

• _____ inches from _____ to _____ ft.

Material _____

Wt. per foot _____ or wall thickness _____ in.

• Screen size and mesh for each zone (where applicable)

• _____ inches from _____ to _____ ft.

• Mesh size _____ Type _____

• _____ inches from _____ to _____ ft.

• Mesh size _____ Type _____

• _____ inches from _____ to _____ ft.

• Mesh size _____ Type _____

• _____ inches from _____ to _____ ft.

• Mesh size _____ Type _____

• Gravel pack

• From _____ to _____ ft.

• From _____ to _____ ft.

• Grout

• From *0* to *50* ft. Type *pressure*

• From _____ to _____ ft. Type _____

2. WATER DATA • Water temperature _____ OF

• Static water level (unpumped level-measured) *30* ft.

• Stabilized measured pumping water level *164* ft.

• Stabilized yield *9* gpm after *4* hours

Natural Flow: Yes _____ No _____ flow rate _____ gpm

Comment on quality _____

3. WATER ZONES: From _____ To _____

From _____ To _____ From _____ To _____

From _____ To _____ From _____ To _____

4. USE DATA:

Type of use: Drinking Livestock Watering _____

Irrigation _____ Food processing _____ Household

Manufacturing _____ Fire safety _____ Cleaning _____

Recreation _____ Aesthetic _____ Cooling or heating _____

Injection _____ Other _____

• Type of facility: Domestic Public water supply _____

Public institution _____ Farm _____ Industry _____

Commercial _____ Other _____

5. PUMP DATA: Type _____ • Rated H.P. _____

• Intake depth _____ • Capacity _____ at _____ head

6. WELLHEAD: Type well seal _____

Pressure tank _____ gal. Loc. _____

Sample tap _____ Measurement port _____

Well vent _____ Pressure relief valve _____

Gate valve _____ Check valve (when required) _____

Electrical disconnect switch on power supply _____

7. DISINFECTION: Well disinfected _____ yes _____ no _____

Date _____ Disinfectant used _____

Amount _____ Hours used _____

8. ABANDONMENT (where applicable) • yes _____ no _____

Casing pulled yes _____ no _____ not applicable _____

Plugging grout From _____ to _____ material _____

Owner Robert Saunders

9. State law requires submitting to the Virginia State Water Control Board information about groundwater and wells for every well made in the State, intended for water, or any other non-exempt well. This information must be submitted whether the well is completed, on standby, or abandoned. Information required includes: an accurately and completely prepared water well completion report, full data from any aquifer pumping tests, drill cuttings taken at ten foot intervals (unless exemption is secured), the results of any chemical analyses, and copies of any geophysical logs. Quarterly pumpage and use reports are required from owners of public supply and industrial wells. County or State permits to drill may be required in some parts of the state. Some counties require submission of a water well completion report. The Virginia State Health Department requires a water well completion report for public supply wells.


10. DRILLERS LOG (use additional Sheets if necessary)

11.

12. DIAGRAM OF WELL CONSTRUCTION (with dimensions)

DEPTH (feet)		TYPE OF ROCK OR SOIL (color, material, fossils, hardness, etc.)	REMARKS (water, casing, cavities, broken, core, shot, etc.)	Drilling Time (Min.)
From	To			
0	45	Brown soil		
45	165	Sandstone		

Well 165 ft
57 ft casing
50 ft gravel
air tight cap.

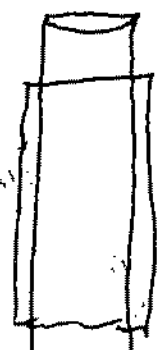

13. Well lot dedicated? _____ Size _____ ft. X _____ ft.; Well house? _____
Distance to nearest pollutant source _____ ft.; Type _____
Distance to nearest property line _____ ft.; Building _____ ft.

14. WATER SERVICE PIPE: Checked under _____ p. s. i. for _____
minutes. Pipe size _____ inches, Material _____
Installer _____
Date _____

15. I certify that the information contained herein is true and correct and that this well and/or system has been installed and constructed in accordance with the requirements for well construction as specified in compliance with appropriate county or independent city ordinances and the laws and rules of the Commonwealth of Virginia.

State Water Control Board Regional Offices

Valley Reg. Off.
116 North Main Street
P. O. Box 268
Bridgewater, Va. 22812
703-828-2595

Southwest Reg. Off.
408 East Main Street
P. O. Box 476
Abingdon, Va. 24210
703-628-5183

West Central Reg. Off.
Executive Park
5312 Peters Creek Road
Roanoke, Va. 24019
703-982-7432

Piedmont Reg. Off.
4010 West Broad Street
P. O. Box 6616
Richmond, Va. 23230
804-257-1006

Tidewater Reg. Off.
287 Pembroke Office Park
Suite 310 Pembroke No. 2
Va. Beach, Va. 23462
804-499-8742

Northern Virginia Reg. Off.
5515 Cherokee Avenue
Suite 404
Alexandria, Va. 22312
703-750-9111

Signature Raymond L. Curtis (Seal) Date 11/22/93
(Well driller or authorized person) License No. 035303