

COMMONWEALTH OF VIRGINIA
 WATER WELL COMPLETION REPORT
 Certification of Completion/County Permit

BWCM No. _____

24A-3-26

RECITAL

Regulatory Board
 1143
 107th Hamilton Street
 Alexandria, Virginia 22200

County/City STAFFORD CO.
 County/City Stamp

SWCB Permit _____
 County Permit _____
 Certification of inspecting official:
 This well does _____ does not _____
 meet code/low requirements.
 S. _____
 Date _____
 For Office Use

Virginia Plane Coordinates
 _____ N
 _____ E
 Latitude & Longitude
 _____ N
 _____ W
 No. Map No. _____
 Location _____
 Information _____
 Technology _____
 River Basin _____
 Province _____
 Type logs _____
 Cuttings _____
 Water Analysis _____
 Aquifer Test _____

Owner Lake Stafford Farms
 Well Designation or Number _____
 Address _____
 Phone _____
 Drilling Contractor: Northern Virginia Drilling
 Address Route 2, Box 1084
Nokesville, VA 22123
 Phone (703) 361-6859

WS-93-63
 Tax Map I.D. No. _____
 Subdivision Kings Grant
 Section _____
 Block _____
 Lot 26
 Class Well I _____ IIA _____
 IIB _____ IIA _____ IIB
 IIC _____ IID _____ IIE _____

WELL LOCATION: _____ (feet/miles _____ direction) of _____
 and _____ feet/miles _____ (direction) of _____
 (if possible please include map showing location marked)
 Date started 7-25-94 • Date completed 7-25-94 Type rig Air Rotary

WELL DATA: Needed _____ Disposed _____
 Total depth 340 ft.
 Depth to bedrock 90 ft.
 Hole size (Also include reamed zones)
 • 10 inches from 0 to 105 1/2 ft.
 • 6 1/2 inches from 105 1/2 to 340 ft.
 • _____ inches from _____ to _____ ft.
 Casing size (I.D.) and material
 • 6 1/4 inches from 0 to 107 ft.
 Material Steel
 Wt. per foot 13 or wall thickness 1 1/8 in.
 • _____ inches from _____ to _____ ft.
 Material _____
 Wt. per foot _____ or wall thickness _____ in.
 • _____ inches from _____ to _____ ft.
 Material _____
 Wt. per foot _____ or wall thickness _____ in.
 Screen size and mesh for each zone (where applicable)
 • _____ inches from _____ to _____ ft.
 • Mesh size _____ Type _____
 • _____ inches from _____ to _____ ft.
 • Mesh size _____ Type _____
 Gravel Pack
 • From _____ to _____ ft.
 • From _____ to _____ ft.
 Grout
 • From 0 to 90' ft. Type Cement
 • From 90' to 105 1/2 ft. Type Rock cuttings


WATER DATA: Water Temperature _____ °F
 • Static water level (unpumped level-measured) 50
 • Stabilized measured pumping water level _____
 • Stabilized yield 7 gpm after 1 hours
 Natural Flow: Yes _____ No flow rate: _____ gpm
 Comment on quality Clear
 3. WATER ZONES: From 320 To 324
 From _____ To _____ From _____ To _____
 From _____ To _____ From _____ To _____
 USE DATA:
 Type of use: Drinking Livestock Watering _____
 Irrigation _____ Food processing _____ Household
 Manufacturing _____ Fire Safety _____ Cleaning _____
 Recreation _____ Aesthetic _____ Cooling or heating _____
 Injection _____ Other _____
 • Type of facility Domestic Public water supply _____
 Public institution _____ Farm _____ Industry _____
 Commercial _____ Other _____
 5. PUMP DATA: Type _____ • Rated H.P. _____
 • Intake depth _____ • Capacity _____ at _____ head
 6. WELLHEAD: Type well seal _____
 Pressure Tank _____ gal. Loc _____
 Sample tap _____ Measurement port _____
 Well vent _____ Pressure relief valve _____
 Gate valve _____ Check valve (when required) _____
 Electrical disconnect switch on power supply _____
 7. DISINFECTION: Well disinfected _____ Yes _____ No _____
 Date _____ Disinfectant used _____
 Amount _____ Hours used _____
 8. ABANDONMENT (where applicable) • Yes _____ No _____
 Casing pulled Yes _____ No _____ Not Applicable _____
 Plugging grout From _____ to _____ material _____

OVER

The law requires submitting to the Virginia State Water Control Board information about groundwater and wells for every well made in the state intended for water, or any other non exempt well. This information must be submitted whether the well is completed, on standby, or abandoned. Information required includes: an accurately and completely prepared water well completion report, full data from any aquifer pumping tests, drill cuttings taken at ten foot intervals (unless exemption is secured), the results of any chemical analysis, and copies of any geophysical logs. Quarterly pumpage and use reports are required from owners of public supply and industrial wells. County or State permits to drill may be required in some parts of the state. Some counties require submission of a water well completion report. The Virginia State Health Department requires a water well completion report for public supply wells.

10. DRILLERS LOG (use additional sheets if necessary)

DEPTH (feet)		TYPE OF ROCK OR SOIL (color, material, fossils, hardness etc.)	REMARKS (water, caving, cavities, broken, core, shot, etc.)
From	To		
0	90	DUEBUNDEN	
70	340	Grey Granite	

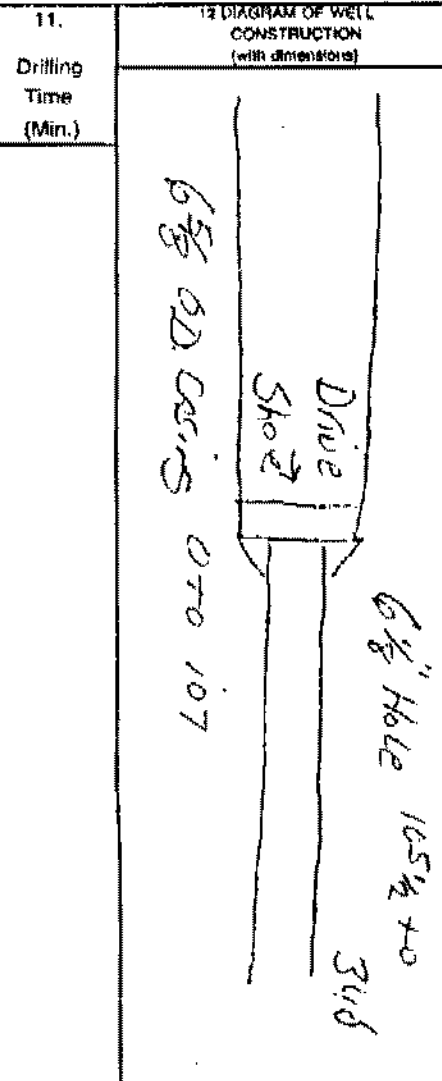

State Water Control Board Regional Offices

Valley Reg. Off.
116 North Main Street
P.O. Box 288
Bridgewater, Va. 22812
703-828-2595

Piedmont Reg. Off.
4010 West Broad Street
P.O. Box 6616
Richmond, Va. 23230
804-257-1006

Southwest Reg. Off.
408 East Main Street
P.O. Box 476
Abingdon, Va. 24210
703-620-5183

Tidewater Reg. Off.
287 Pembroke Office Park
Suite 310 Pembroke No. 2
Va. Beach, Va. 23462
804-499-8742

West Central Reg. Off.
Executive Park
5312 Peters Creek Road
Roanoke, Va. 24018
703-982-7432

Northern Virginia Reg. Off.
5515 Cherokees Avenue
Suite 404
Alexandria, Va. 22312
703-750-9111

13. Well lot dedicated? _____ : Size _____ ft. x _____ ft.: Well house? _____
Distance to nearest pollutant source _____ ft., Type _____
Distance to nearest property line _____ ft., Building _____ ft.

14. WATER SERVICE PIPE: Checked under _____ P.S.I. for _____
minutes. Pipe size _____ inches. Material _____
Installer _____
Date _____

15. I certify that the information contained herein is true and correct and that this well and/or system has been installed and constructed in accordance with the requirements for well construction as specified in compliance with appropriate county or independent city ordinances and the laws and rules of the Commonwealth of Virginia.

Signature [Signature] (Seal, Date 7-25-91)
License No. 056.00