

**COMMONWEALTH OF VIRGINIA
WATER WELL COMPLETION REPORT**

(Certification of Completion/County Permit)

• BWCM No. _____

250-1-3

Water Control Board
P. O. Box 1116
2111 North Hamilton St.
Richmond, Va. 23230

County/City Stafford

County/City Stamp

• Virginia Plane Coordinates
N _____
E _____
Latitude & Longitude
N _____
W _____
• Topo. Map No. 183A
• Elevation _____ ft.
• Formation _____
• Lithology _____
• River Basin _____
• Province _____
• Type Logs D. L.
• Cuttings N. A.
• Water Analysis _____
• Aquifer Test _____

• Owner Alfred J. Theriault
• Well Designation or Number _____
Address 465 Waterway Drive
Stafford Co. 22026
Phone 1-703-624-6511
• Drilling Contractor John L. Danielson, Jr., Inc.
Address 4616 Hood Drive
Fredericksburg, Virginia 22401
Phone (703) 898-6025

SWCB Permit _____
County Permit _____
Certification of inspecting official:
This well does _____ does not _____
meet code/low requirements.
S. _____
Date _____
For Office Use
189-88-436
9-23-88
Tax Map I.D. No. 25-44-3
Subdivision _____
Section _____
Block _____
Lot _____
Class Well: I _____, II A _____
II B , III A _____, III B _____
III C _____, III D _____, III E _____

WELL LOCATION: _____ (feet/miles _____ direction) of _____
and _____ (feet/miles _____ direction) of Intersection 6125 649
(If possible please include map showing location marked)

Date started 12/21/88 • Date completed 12/22/88 Type rig Air Rotary

Approximate Drawdown 40 feet.

1. WELL DATA: New Reworked _____ Deepened _____
• Total depth 160 ft.
• Depth to bedrock 94 ft.
• Hole size (Also include reamed zones)
• 10 inches from 0 to 60 ft.
• 8 1/2 inches from 60 to 94 ft.
• 6 1/2 inches from 94 to 160 ft.
• Casing size (I.D.) and material
• 6 1/2 inches from +1 to 94 ft.
Material Steel
Wt. per foot 13.24 or wall thickness .188 in.
• _____ inches from _____ to _____ ft.
Material _____
Wt. per foot _____ or wall thickness _____ in.
• _____ inches from _____ to _____ ft.
Material _____
Wt. per foot _____ or wall thickness _____ in.
• Screen size and mesh for each zone (where applicable)
• _____ inches from _____ to _____ ft.
• Mesh size _____ Type _____
• _____ inches from _____ to _____ ft.
• Mesh size _____ Type _____
• Gravel pack
• From _____ to _____ ft.
• From _____ to _____ ft.
• Grout
• From 0 to 50 ft. Type Neat Cement
• From _____ to _____ ft. Type _____

2. WATER DATA • Water temperature _____ of _____
• Static water level (unpumped level measured) 40 ft.
• Stabilized measured pumping water level _____ ft.
• Stabilized yield 15 gpm after _____ hour
Natural Flow: Yes _____ No flow rate _____ gpm
Comment on quality _____
3. WATER ZONES: From 153 To 154
From _____ To _____ From _____ To _____
From _____ To _____ From _____ To _____
4. USE DATA:
Type of use: Drinking Livestock Watering _____
Irrigation _____ Food processing _____ Household
Manufacturing _____ Fire safety _____ Cleaning _____
Recreation _____ Aesthetic _____ Cooling or heating _____
Injection _____ Other _____
• Type of facility: Domestic Public water supply _____
Public institution _____ Farm _____ Industry _____
Commercial _____ Other _____
5. PUMP DATA: Type _____ Rated H.P. _____
• Intake depth _____ Capacity _____ at _____ head
6. WELLHEAD: Type well seal _____
Pressure tank _____ gal. Loc. _____
Sample tap _____ Measurement port _____
Well vent _____ Pressure relief valve _____
Gate valve _____ Check valve (when required) _____
Electrical disconnect switch on power supply _____
7. DISINFECTION: Well disinfected _____ yes _____ no _____
Date _____ Disinfectant used _____
Amount _____ Hours used _____
8. ABANDONMENT (where applicable) • yes _____ no _____
Casing pulled yes _____ no _____ not applicable _____
Plugging grout From _____ to _____ material _____
Pump installed through Mr. Blaker

Installed watertight top
Large battery pump approx 100'
OVER


Mercury Alfred J.
 Owner Blake John #3
Stafford 649

9. State law requires submitting to the Virginia State Water Control Board information about groundwater and wells for every well made in the intended for water, or any other non-exempt well. This information must be submitted whether the well is completed, on standby, or abandoned. Information required includes: an accurately and completely prepared water well completion report, full data from any aquifer pumping tests, drill cuttings taken at ten foot intervals (unless exemption is secured), the results of any chemical analyses, and copies of any geophysical logs. Quarterly pumping and use reports are required from owners of public supply and industrial wells. County or State permits to drill may be required in some parts of the state. Some counties require submission of a water well completion report. The Virginia State Health Department requires a water well completion report for public supply wells.

10. DRILLERS LOG (use additional Sheets if necessary)				11.	12. DIAGRAM OF WELL CONSTRUCTION (with dimensions)
DEPTH (feet)		TYPE OF ROCK OR SOIL (color, material, fossils, hardness, etc.)	REMARKS (water, caving, cavities, broken, core, shot, etc.)	Drilling Time (Min.)	
From	To				
0	10	brown clay			Water top
10	40	micaceous formation red			Pipes 13/16
40	40	micaceous formation brown			Grout 50'
40	94	soft brown rock			95'
94	160	blue rock			Cas. 64'

Approximate Water Zones
153' to 154'

Dept 160'

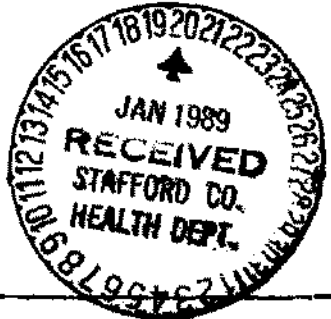

13. Well lot dedicated? _____; Size _____ ft. X _____ ft.; Well house? _____
 Distance to nearest pollutant source _____ ft., Type _____
 Distance to nearest property line _____ ft., Building _____ ft.

14. WATER SERVICE PIPE: Checked under _____ p. s. i. for _____ minutes. Pipe size _____ inches, Material _____
 Installer _____
 Date _____

15. I certify that the information contained herein is true and correct and that this well and/or system has been installed and constructed in accordance with the requirements for well construction as specified in compliance with appropriate county or independent city ordinances and the laws and rules of the Commonwealth of Virginia.

Signature Chris N. Danaher (Seal), Date 1/4/89
 (Well Driller or authorized person) License No. _____

- State Water Control Board Regional Offices**
- Valley Reg. Off.
116 North Main Street
P. O. Box 268
Bridgewater, Va. 22812
703-828-2595
 - Southwest Reg. Off.
408 East Main Street
P. O. Box 476
Abingdon, Va. 24210
703-628-5183
 - West Central Reg. Off.
Executive Park
3312 Peters Creek Road
Roanoke, Va. 24019
703-982-7432
 - Piedmont Reg. Off.
4010 West Broad Street
P. O. Box 6616
Richmond, Va. 23230
804-257-1006
 - Tidewater Reg. Off.
287 Pembroke Office Park
Suite 310 Pembroke No. 2
Va. Beach, Va. 23462
804-499-8742
 - Northern Virginia Reg. Off.
5515 Cherokee Avenue
Suite 404
Alexandria, Va. 22312
703-750-9111