


(Certification of Completion/County Permit)

25C-1-19

State Water Control Board  
P. O. Box 1114  
2111 North Highland Ave.  
Richmond, Va. 23238

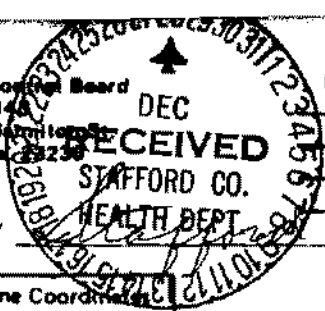

County/City

County/City Stamp

SWCB Permit \_\_\_\_\_  
County Permit \_\_\_\_\_  
Certification of inspecting official:  
This well does \_\_\_\_\_ does not  
meet code/low requirements.  
S. \_\_\_\_\_  
Date \_\_\_\_\_

For Office Use

189-88-469 <sup>9/21/88</sup> *Rudolph*  
Tax Map I.D. No. 25-49-19  
Subdivision Blake Farm  
Section \_\_\_\_\_  
Block \_\_\_\_\_  
Lot 19  
Class Well I \_\_\_\_\_ IIA \_\_\_\_\_  
IIB  I IIIA \_\_\_\_\_ IIIB \_\_\_\_\_  
IIC \_\_\_\_\_ IIID \_\_\_\_\_ IIIF \_\_\_\_\_

• Virginia Plane Coordinates  
N \_\_\_\_\_  
E \_\_\_\_\_  
Latitude & Longitude  
N \_\_\_\_\_  
W \_\_\_\_\_  
• Topo. Map No. 183A  
• Elevation \_\_\_\_\_ ft.  
• Formation \_\_\_\_\_  
• Lithology \_\_\_\_\_  
• River Basin \_\_\_\_\_  
• Province \_\_\_\_\_  
• Type Logs D. L.  
• Cuttings N. A.  
• Water Analysis \_\_\_\_\_  
• Aquifer Test \_\_\_\_\_

• Owner Beverly A. Canady  
• Well Designation or Number \_\_\_\_\_  
Address 104 Weyatt Drive  
Fredericksburg, Va. 22401  
Phone H 898-2382  
w. 898-1173  
• Drilling Contractor John L. Danielson, Jr., Inc.  
Address 4616 Hood Drive  
Fredericksburg, Virginia 22401  
Phone (703) 898-6025

WELL LOCATION: \_\_\_\_\_ (feet/miles \_\_\_\_\_ direction) of \_\_\_\_\_  
and \_\_\_\_\_ (feet/miles \_\_\_\_\_ direction) of \_\_\_\_\_  
(If possible please include map showing location marked) 1 MILE S. of intersection 612 & 49  
Date started 10/26/88 • Date completed 10/26/88 Type rig Air Rotary

I. WELL DATA: New  Reworked \_\_\_\_\_ Deepened \_\_\_\_\_

• Total depth 180 ft.  
• Depth to bedrock 60 ft.  
• Hole size (Also include reamed zones)  
• 10 inches from 0 to 55 ft.  
• 8 1/2 inches from 55 to 60 ft.  
• 6 inches from 60 to 180 ft.  
• Casing size (I.D.) and material  
• 6 1/4 inches from +1 to 60 ft.  
Material PVC Well Casing - Schedule 40  
Wt. per foot \_\_\_\_\_ or wall thickness \_\_\_\_\_ in.  
• \_\_\_\_\_ inches from \_\_\_\_\_ to \_\_\_\_\_ ft.  
Material \_\_\_\_\_  
Wt. per foot \_\_\_\_\_ or wall thickness \_\_\_\_\_ in.  
• \_\_\_\_\_ inches from \_\_\_\_\_ to \_\_\_\_\_ ft.  
Material \_\_\_\_\_  
Wt. per foot \_\_\_\_\_ or wall thickness \_\_\_\_\_ in.  
• Screen size and mesh for each zone (where applicable)  
• \_\_\_\_\_ inches from \_\_\_\_\_ to \_\_\_\_\_ ft.  
• Mesh size \_\_\_\_\_ Type \_\_\_\_\_  
• \_\_\_\_\_ inches from \_\_\_\_\_ to \_\_\_\_\_ ft.  
• Mesh size \_\_\_\_\_ Type \_\_\_\_\_  
• Gravel pack  
• From \_\_\_\_\_ to \_\_\_\_\_ ft.  
• From \_\_\_\_\_ to \_\_\_\_\_ ft.  
• Grout  
• From 0 to 50+ ft. Type Pressure Grouting  
Neat Cement  
• From \_\_\_\_\_ to \_\_\_\_\_ ft. Type \_\_\_\_\_  
Installed water receipt cap  
Support setting pump @ approx 85'

Approximate Drawdown \_\_\_\_\_ feet.  
2. WATER DATA • Water temperature \_\_\_\_\_ °F  
• Static water level (unpumped level measured) \_\_\_\_\_ ft  
• Stabilized measured pumping water level \_\_\_\_\_ ft  
• Stabilized yield 30 gpm after \_\_\_\_\_ hours  
Natural Flow: Yes \_\_\_\_\_ No \_\_\_\_\_ flow rate \_\_\_\_\_ gpm  
Comment on quality \_\_\_\_\_

3. WATER ZONES: From 172 To 173  
From \_\_\_\_\_ To \_\_\_\_\_ From \_\_\_\_\_ To \_\_\_\_\_  
From \_\_\_\_\_ To \_\_\_\_\_ From \_\_\_\_\_ To \_\_\_\_\_

4. USE DATA:  
Type of use: Drinking  Livestock Watering \_\_\_\_\_  
Irrigation \_\_\_\_\_ Food processing \_\_\_\_\_ Household   
Manufacturing \_\_\_\_\_ Fire safety \_\_\_\_\_ Cleaning \_\_\_\_\_  
Recreation \_\_\_\_\_ Aesthetic \_\_\_\_\_ Cooling or heating \_\_\_\_\_  
Injection \_\_\_\_\_ Other \_\_\_\_\_  
• Type of facility: Domestic  Public water supply \_\_\_\_\_  
Public institution \_\_\_\_\_ Farm \_\_\_\_\_ Industry \_\_\_\_\_  
Commercial \_\_\_\_\_ Other \_\_\_\_\_

5. PUMP DATA: Type Sub • Rated H.P. 1/2 H.P. 90 C.R.D. 1/2  
• Intake depth 85 • Capacity 10 at 85 head

6. WELLHEAD: Type well seal \_\_\_\_\_  
Pressure tank \_\_\_\_\_ gal. Loc. \_\_\_\_\_  
Sample tap \_\_\_\_\_ Measurement port \_\_\_\_\_  
Well vent \_\_\_\_\_ Pressure relief valve \_\_\_\_\_  
Gate valve \_\_\_\_\_ Check valve (when required) \_\_\_\_\_  
Electrical disconnect switch on power supply \_\_\_\_\_

7. DISINFECTION: Well disinfected \_\_\_\_\_ yes \_\_\_\_\_ no \_\_\_\_\_  
Date \_\_\_\_\_ Disinfectant used \_\_\_\_\_  
Amount \_\_\_\_\_ Hours used \_\_\_\_\_

8. ABANDONMENT (where applicable) • yes \_\_\_\_\_ no \_\_\_\_\_  
Casing pulled yes \_\_\_\_\_ no \_\_\_\_\_ not applicable \_\_\_\_\_  
Plugging grout From \_\_\_\_\_ to \_\_\_\_\_ material \_\_\_\_\_  
Pump installed through John L. Danielson

OVER

9. State law requires submitting to the Virginia State Water Control Board information about groundwater and wells for every well made in the State intended for water, or any other non-exempt well. This information must be submitted whether the well is completed, on standby, or abandoned. Information required includes: an accurately and completely prepared water well completion report; full data from any aquifer pumping tests, drill cuttings taken at ten foot intervals (unless exemption is secured), the results of any chemical analyses; and copies of any geophysical logs. Quarterly pumping and use reports are required from owners of public supply and industrial wells. County or State permits to drill may be required in some parts of the state. Some counties require submission of a water well completion report. The Virginia State Health Department requires a water well completion report for public supply wells.


10. DRILLERS LOG (use additional Sheets if necessary)

DEPTH (feet)		TYPE OF ROCK OR SOIL (color, material, fossils, hardness, etc.)	REMARKS (water, caving, cavities, broken, core, shot, etc.)
From	To		
0	20	red clay	
20	40	micaceous formation red	
40	60	micaceous formation brown	
60	180	hard blue rock	

Approximate  
Water Zones  
172 & 173

11.  
Drilling  
Time  
(Min.)

12. DIAGRAM OF WELL CONSTRUCTION (with dimensions)

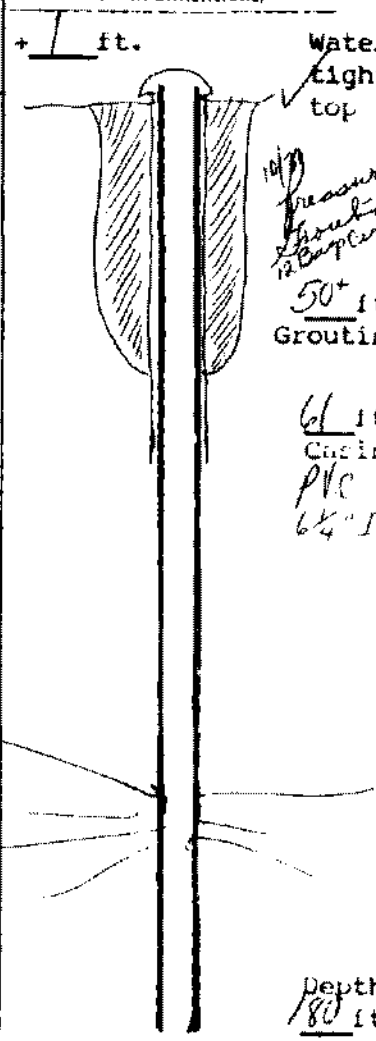

13. Well lot dedicated? \_\_\_\_\_; Size \_\_\_\_\_ ft. X \_\_\_\_\_ ft.; Well house? \_\_\_\_\_  
 Distance to nearest pollutant source \_\_\_\_\_ ft., Type \_\_\_\_\_  
 Distance to nearest property line \_\_\_\_\_ ft., Building \_\_\_\_\_ ft.

14. WATER SERVICE PIPE: Checked under \_\_\_\_\_ p.s.i. for \_\_\_\_\_  
 minutes. Pipe size \_\_\_\_\_ inches, Material \_\_\_\_\_  
 Installer \_\_\_\_\_  
 Date \_\_\_\_\_

15. I certify that the information contained herein is true and correct and that this well and/or system has been installed and constructed in accordance with the requirements for well construction as specified in compliance with appropriate county or independent city ordinances and the laws and rules of the Commonwealth of Virginia.  
 Signature Russell D. Daniels (Well driller or authorized person) Date 11/1/88  
 License No. \_\_\_\_\_

State Water Control Board Regional Offices

Valley Reg. Off.  
116 North Main Street  
P. O. Box 268  
Bridgewater, Va. 22812  
703-828-2595

Piedmont Reg. Off.  
4010 West Broad Street  
P. O. Box 6616  
Richmond, Va. 23230  
804-257-1006

Southwest Reg. Off.  
408 East Main Street  
P. O. Box 476  
Abingdon, Va. 24210  
703-628-5183

Tidewater Reg. Off.  
287 Pembroke Office Park  
Suite 310 Pembroke No. 2  
Va. Beach, Va. 23462  
804-499-8742

West Central Reg. Off.  
Executive Park  
5312 Peters Creek Road  
Roanoke, Va. 24019  
703-982-7432

Northern Virginia Reg. Off.  
5515 Cherokee Avenue  
Suite 404  
Alexandria, Va. 22312  
703-730-9111