

John
1466 Crown Drive
Bedfordburg, Va.
786-3914 / 786-6793
Fax 785-9929

22407 Commonwealth of Virginia
Uniform Water Well Completion Report

25C-3-36
~~25-49-376~~

OWNER
Address John Salter

Permit issued to
James R. Pittman, Jr.
20, Box 352
Gasparville, Va. 22463

Tax Map ID 75 15 0 J1
VDH Permit 189-89-290
VWCB Permit _____
VWCB ID _____

Phone _____
Location Blake Farm - Sect 3 - Lot 36 (649)
183A - 8th. W of State 76491612 / 310M. N. of 649
Well Classification IIIA IIIB IIIC IV

County Stafford
12/14/89 Richard Smith
2/18/90 A. W. Deed

* Well Data *

General Information

Drilling Method Air Rotary
Depth to Bedrock 96
Static Water Level 40
Well Disinfected (Y or N) _____

Date Completed 6/30/89
Yield 30 (GPM)
Stabilized Water Level 140
Disinfectant Used _____

Total Depth of Well 240
Length of Test 1 HR
Natural Flow (Rate) _____
Amount Used _____

Casing

From 7 To 75
Size 6 7/8" Material P.V.C.
Weight/Schedule SDR 27

From 75 To 115
Size 6 7/8" Material P.V.C.
Weight/Schedule SDR 21

From 100' To 200'
From 220 To 240
Size 4" Material P.V.C.
Weight/Schedule Sch. 40

Gravel Pack

From _____ To _____

From _____ To _____

From _____ To _____

Hole size

10" From 0 to 115ft.

6" from 115 to 240ft.

_____ " from _____ to _____ ft.

Grout

From 0 To 50'
Bore Hole Size 10" 7/16"
Type Bentonite
Method Pressure Grouting

From _____ To _____
Bore Hole Size _____
Type _____
Method _____

From _____ To _____
Bore Hole Size _____
Type _____
Method _____

Water Zones or Screened Intervals

From 200 To 220
Mesh Size 20 Diam 4" P.V.S.
From _____ To _____
Mesh Size _____ Diam _____

From 160 To 161
Mesh Size _____ Diam _____
From 219 To 220
Mesh Size _____ Diam _____

From _____ To _____
Mesh Size _____ Diam _____
From _____ To _____
Mesh Size _____ Diam _____

* Use Data *

Private Well: Domestic Agricultural _____ Industrial _____ Monitoring _____
Public Well: Community _____ Non Community _____

* Abandonment Information *

Bored or Dug Wells

Casing Removed, Y or N? _____
If Y, Depth to which casing was removed: _____
Depth and Type of Fill: _____
Source of Fill _____
Bentonite Plugs: From _____ to _____ From _____ to _____

Wells other than Bored Wells

Casing removed, Y or N? _____
Depth to which casing was removed: _____
Applicable, depth(c), and type of gravel/sand fill: _____
Source of gravel or sand: _____
Cement: From _____ to _____ From _____ to _____

Method of permanently marking location:


Installed watertight top
Suggest setting pump @ approx 160 ft.
You will encounter 4" casing @ approx 160 FE.
Suggest keeping torque arrestor & centralizer out of 4" casing

Joe Sel

Blake James #36
- Stepped off #649 -
 Drillers Log

Depth	Description of Formation or Sediment	Remarks
0	10	Red Clay
10	96	Sandy Brown Clay
96	155	Soft Brown Rock
155	240	Light Grey Rock

DIAGRAM
(NOT TO SCALE)

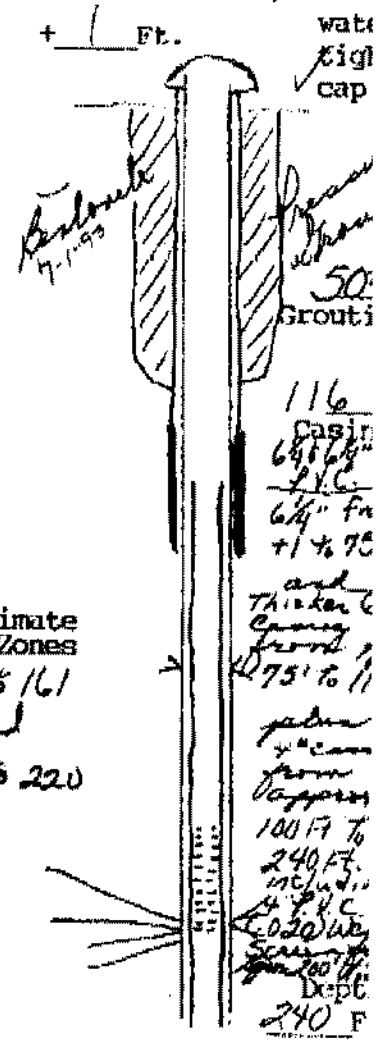

Approximate
Water Zones
160 to 161
and
219 to 220

(Use additional Sheets if necessary)

I certify that the information contained here is true and that this well was installed and constructed in accordance with the permit and further that the well complies with all applicable state and local regulations, ordinances and laws.

Name JOHN L. DANIELSON, JR., INC.

Address 1616 HOOD DRIVE
FREDERICKSBURG, VIRGINIA 22408

Phone (703) 898-6025 / 898-9355

Drillers Signature *John L. Danielson, Jr.*
 Date 7/19/83 Representing JOHN L. DANIELSON, JR., INC.

Virginia Contractors License Number CLASS A 2701 014084A H/H WWC