

Commonwealth of Virginia

Uniform Water Well Completion Report

25C-3-39

Richmond, Va 22404

785-0921 / 785-0634 Permit originally issued to:

Owner For Sale  
Address \_\_\_\_\_  
Phone \_\_\_\_\_  
Location Blake Farm Lot #39

Rosa Brothers Bu. Hrs.

Tax Map ID 25C-44-8-34  
VDH Permit 189-87-293  
WVWC Permit \_\_\_\_\_  
WVWC ID \_\_\_\_\_  
County Stafford  
2-4-90 Richard Smith  
2-8-90 Tom Deal

Well Classification IIIA IIIB IIIC IV  
\* Well Data \*

25C

General Information  
Drilling Method Air Rotary  
Depth to Bedrock 120  
Static Water Level 46  
Well Disinfected (Y or N) \_\_\_\_\_

Date Completed 9/23/93  
Yield 30 (GPM)  
Stabilized Water Level 140  
Disinfectant Used \_\_\_\_\_

Total Depth of Well 320  
Length of Test 1 Hr  
Natural Flow (Rate) \_\_\_\_\_  
Amount Used \_\_\_\_\_

Casing  
From +1 To 152  
Size 6 1/4" Material Steel  
Weight/Schedule 188 (131b/R.)

From \_\_\_\_\_ To \_\_\_\_\_  
Size \_\_\_\_\_ Material \_\_\_\_\_  
Weight/Schedule \_\_\_\_\_

From \_\_\_\_\_ To \_\_\_\_\_  
Size \_\_\_\_\_ Material \_\_\_\_\_  
Weight/Schedule \_\_\_\_\_

Gravel Pack  
From \_\_\_\_\_ To \_\_\_\_\_

From \_\_\_\_\_ To \_\_\_\_\_

From \_\_\_\_\_ To \_\_\_\_\_

Hole size  
10" from 0 to 152 ft.

6" from 152 to 320 ft.

" from \_\_\_\_\_ to \_\_\_\_\_ ft.

Grout  
From 0 To 50'  
Bore Hole Size 10" 9/29/93  
Type Bentonite  
Method Pressure Grouting

From \_\_\_\_\_ To \_\_\_\_\_  
Bore Hole Size \_\_\_\_\_  
Type \_\_\_\_\_  
Method \_\_\_\_\_

From \_\_\_\_\_ To \_\_\_\_\_  
Bore Hole Size \_\_\_\_\_  
Type \_\_\_\_\_  
Method \_\_\_\_\_

Water Zones or Screened Intervals  
From 200 To 201  
Mesh Size \_\_\_\_\_ Diam \_\_\_\_\_  
From 300 To 301  
Mesh Size \_\_\_\_\_ Diam \_\_\_\_\_

From \_\_\_\_\_ To \_\_\_\_\_  
Mesh Size \_\_\_\_\_ Diam \_\_\_\_\_  
From \_\_\_\_\_ To \_\_\_\_\_  
Mesh Size \_\_\_\_\_ Diam \_\_\_\_\_

From \_\_\_\_\_ To \_\_\_\_\_  
Mesh Size \_\_\_\_\_ Diam \_\_\_\_\_  
From \_\_\_\_\_ To \_\_\_\_\_  
Mesh Size \_\_\_\_\_ Diam \_\_\_\_\_

\* Use Data \*

Private Well: Domestic  Agricultural \_\_\_\_\_ Industrial \_\_\_\_\_ Monitoring \_\_\_\_\_  
Public Well: Community \_\_\_\_\_ Non Community \_\_\_\_\_

\* Abandonment Information \*

Bored or Dug Wells  
Casing Removed, Y or N? \_\_\_\_\_  
If Y, Depth to which casing was removed: \_\_\_\_\_  
Depth and Type of Fill: \_\_\_\_\_  
Source of Fill \_\_\_\_\_  
Bentonite Plugs: From \_\_\_\_\_ to \_\_\_\_\_ From \_\_\_\_\_ to \_\_\_\_\_


Wells other than Bored Wells  
Casing removed, Y or N? \_\_\_\_\_  
Depth to which casing was removed: \_\_\_\_\_  
Applicable, depth(s), and type of gravel/sand fill: \_\_\_\_\_  
Source of gravel or sand: \_\_\_\_\_  
Cement: From \_\_\_\_\_ to \_\_\_\_\_ From \_\_\_\_\_ to \_\_\_\_\_

Method of permanently marking location: \_\_\_\_\_  
 Installed watertight top  
Suggest setting pump @ approx. 160 ft.

Tim Thompson  
Thompson Building  
Blake Farms #39  
Stafford -

\* Drillers Log \*

Depth	Description of Formation or Sediment	Remarks
0	10	Red Clay
10	126	Brown Sandy Clay
126	152	Soft Brown Shale
152	320	Light Grey Granite

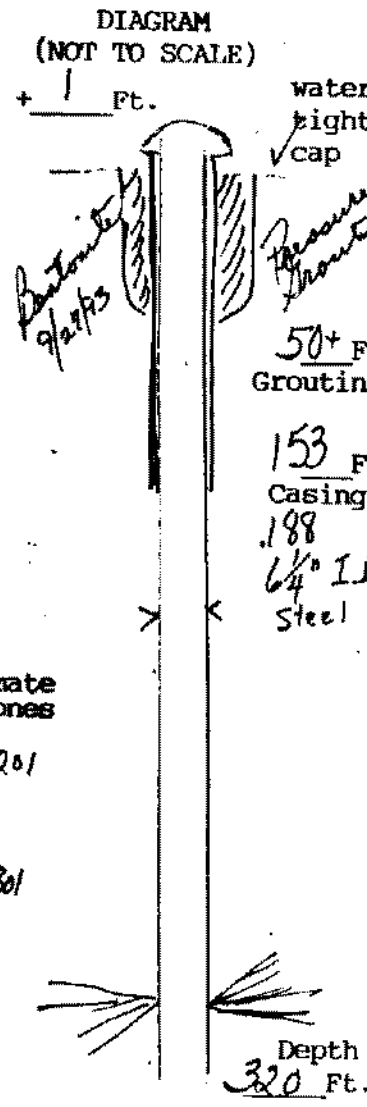

Approximate Water Zones  
 200 to 201  
 and  
 300 to 301

(User additional Sheets if necessary)

I certify that the information contained here is true and that this well was installed and constructed in accordance with the permit and further that the well complies with all applicable state and local regulations, ordinances and laws.

Name JOHN L. DANIELSON, JR., INC.  
 Address 4616 HOOD DRIVE  
FREDERICKSBURG, VIRGINIA 22408  
 Phone (703) 898-6625 / 898-9355

Driller's Signature [Signature]  
 Date 9/27/98 Representing JOHN L. DANIELSON, JR., INC.

Virginia Contractors License Number CLASS A 2701 014084A H/H WWC