

Johnson (de Johnson)  
Clower Drive  
Norfolk, Va 22407  
RF 786-3914 / 786-6793

Commonwealth of Virginia  
Uniform Water Well Completion Report

25C-3-40

Permit issued to \_\_\_\_\_  
Owner Ross Barbara Alden / For Sale  
Address \_\_\_\_\_

Tax Map ID 25-49-3-46  
VDH Permit 189-89-294  
VWCB Permit \_\_\_\_\_  
VWCB ID \_\_\_\_\_  
County Stafford  
12-4-90 Richard Smith  
12-8-90 R.M. Daul

Phone \_\_\_\_\_  
Location Blake Farms Sect 3 Lot 40 C. Culdesac  
1 1/2 Miles W. of Int. v section of 6128 649 & R.M. N of 649 (649)  
Well Classification IIIA \_\_\_\_\_ IIIB  IIIC \_\_\_\_\_ IV \_\_\_\_\_  
183A \* Well Data \*

General Information

Drilling Method Air Rotary  
Depth to Bedrock 93  
Static Water Level 40  
Well Disinfected (Y or N) \_\_\_\_\_

Date Completed 5/21/93  
Yield 12 (GPM)  
Stabilized Water Level 180  
Disinfectant Used \_\_\_\_\_

Total Depth of Well 240  
Length of Test 1 Hr.  
Natural Flow (Rate) \_\_\_\_\_  
Amount Used \_\_\_\_\_

Casing

From +1 To 75  
Size 6 1/4 Material P.V.C.  
Weight/Schedule SDR 27

From 75 To 115  
Size 6 1/4 Material P.V.C.  
Weight/Schedule SDR 21

From \_\_\_\_\_ To \_\_\_\_\_  
Size \_\_\_\_\_ Material \_\_\_\_\_  
Weight/Schedule \_\_\_\_\_

Gravel Pack

From \_\_\_\_\_ To \_\_\_\_\_

From \_\_\_\_\_ To \_\_\_\_\_

From \_\_\_\_\_ To \_\_\_\_\_

Hole size

0 " from 0 to 15 ft.

6 " from 15 to 240 ft.

\_\_\_\_\_ " from \_\_\_\_\_ to \_\_\_\_\_ ft.

Grout

From 0 To 50+  
Bore Hole Size 10"  
Type Bentonite 5/24/93  
Method Pressure Grouting

From \_\_\_\_\_ To \_\_\_\_\_  
Bore Hole Size \_\_\_\_\_  
Type \_\_\_\_\_  
Method \_\_\_\_\_

From \_\_\_\_\_ To \_\_\_\_\_  
Bore Hole Size \_\_\_\_\_  
Type \_\_\_\_\_  
Method \_\_\_\_\_

Water Zones or Screened Intervals

From 160 To 161  
Mesh Size \_\_\_\_\_ Diam \_\_\_\_\_  
From 220 To 221  
Mesh Size \_\_\_\_\_ Diam \_\_\_\_\_

From \_\_\_\_\_ To \_\_\_\_\_  
Mesh Size \_\_\_\_\_ Diam \_\_\_\_\_  
From \_\_\_\_\_ To \_\_\_\_\_  
Mesh Size \_\_\_\_\_ Diam \_\_\_\_\_

From \_\_\_\_\_ To \_\_\_\_\_  
Mesh Size \_\_\_\_\_ Diam \_\_\_\_\_  
From \_\_\_\_\_ To \_\_\_\_\_  
Mesh Size \_\_\_\_\_ Diam \_\_\_\_\_

\* Use Data \*

Private Well: Domestic  Agricultural \_\_\_\_\_ Industrial \_\_\_\_\_ Monitoring \_\_\_\_\_  
Public Well: Community \_\_\_\_\_ Non Community \_\_\_\_\_

\* Abandonment Information \*

Bored or Dug Wells

Casing Removed, Y or N? \_\_\_\_\_  
If Y, Depth to which casing was removed: \_\_\_\_\_  
Depth and Type of Fill: \_\_\_\_\_  
Source of Fill \_\_\_\_\_  
Bentonite Plugs: From \_\_\_\_\_ to \_\_\_\_\_ From \_\_\_\_\_ to \_\_\_\_\_

Wells other than Bored Wells

Casing removed, Y or N? \_\_\_\_\_  
Depth to which casing was removed: \_\_\_\_\_  
Applicable, depth(s), and type of gravel/sand fill: \_\_\_\_\_  
Source of gravel or sand: \_\_\_\_\_  
Cement: From \_\_\_\_\_ to \_\_\_\_\_ From \_\_\_\_\_ to \_\_\_\_\_


Method of permanently marking location: \_\_\_\_\_  
 Installed watertight top  
Suggest setting pump @ approx. 220 ft.

Al Johnson  
Blake Jarns #40  
Stafford 649

\* Drillers Log \*

Depth Description of Formation or Sediment Remarks

0	10	Red Clay
10	92	Brown Sandy Clay
92	115	Brown Shale
115	240	Light Grey Rock

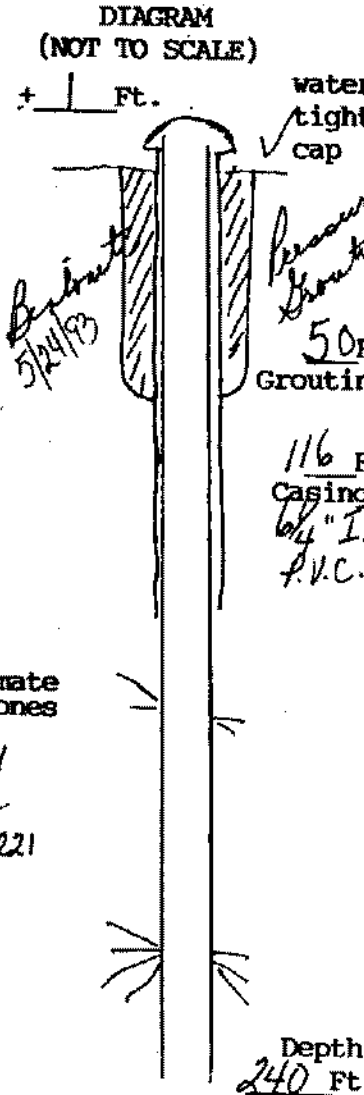

Approximate Water Zones

160 to 161  
 and  
 220 to 221

(User additional Sheets if necessary)

I certify that the information contained here is true and that this well was installed and constructed in accordance with the permit and further that the well complies with all applicable state and local regulations, ordinances and laws.

Name JOHN L. DANIELSON, JR., INC.  
 Address 4616 HOOD DRIVE  
FREDERICKSBURG, VIRGINIA 22408  
 Phone (703) 898-6025 / 898-9355

Drillers Signature Chris N. Danielson, Pres.  
 Date 5/24/93 Representing JOHN L. DANIELSON, JR., INC.

Virginia Contractors License Number CLASS A 2701 014084A H/H WWC