

James C. Peck, Jr.
Cybercrim Notes
P.O. Box 4208
Bedford, VA
898-5689 Fax 898-7640 2240#
Voice 372-6344
Owner Don Sale

Commonwealth of Virginia
Uniform Water Well Completion Report 25C-3-41

Address _____
Phone _____
Location Blake Farm Sect 3 LA 41

Reprint originally submitted:
Rob Brothers Bu. Hous

Tax Map ID 25C-49-3-41
VDH Permit 189-99-295
VWCB Permit _____
VWCB ID _____
County Suffolk
6-11-90 Richard Smith
7-2-90 Ron Deal

Well Classification IIIA _____ IIIB IIIC _____ IV _____
* Well Data *

General Information

Drilling Method air rotary
Depth to Bedrock 123
Static Water Level 40
Well Disinfected (Y or N) _____

Date Completed 9/28/93
Yield 5 (GPM)
Stabilized Water Level 280
Disinfectant Used _____

Total Depth of Well 360
Length of Test 1 Hr
Natural Flow (Rate) _____
Amount Used _____

Casing

From +1 To 142
Size 6 3/4 Material Steel
Weight/Schedule 188 / (13 lb per ft)

From _____ To _____
Size _____ Material _____
Weight/Schedule _____

From _____ To _____
Size _____ Material _____
Weight/Schedule _____

Gravel Pack

From _____ To _____

From _____ To _____

From _____ To _____

Hole size

10" from 0 to 60 ft.

7 7/8" from 60 to 142 ft.

6" from 142 to _____ ft.

Grout

From 0 To 50'
Bore Hole Size 10" 10/4/93
Type Bentonite
Method Pressure Grouting

From _____ To _____
Bore Hole Size _____
Type _____
Method _____

From _____ To _____
Bore Hole Size _____
Type _____
Method _____

Water Zones or Screened Intervals

From 220 To 221
Mesh Size _____ Diam _____
From 340 To 341
Mesh Size _____ Diam _____

From _____ To _____
Mesh Size _____ Diam _____
From _____ To _____
Mesh Size _____ Diam _____

From _____ To _____
Mesh Size _____ Diam _____
From _____ To _____
Mesh Size _____ Diam _____

* Use Data *

Private Well: Domestic Agricultural _____ Industrial _____ Monitoring _____
Public Well: Community _____ Non Community _____

* Abandonment information *

Bored or Dug Wells

Casing Removed, Y or N? _____
If Y, Depth to which casing was removed: _____
Depth and Type of Fill: _____
Source of Fill _____
Bentonite Plugs: From _____ to _____ From _____ to _____

Wells other than Bored Wells

Casing removed, Y or N? _____
Depth to which casing was removed: _____
Applicable, depth(s), and type of gravel/sand fill: _____
Source of gravel or sand: _____
Cement: From _____ to _____ From _____ to _____


Method of permanently marking location: _____
 Installed watertight top
Suggest setting pump @ approx. 300 ft.

Blaker Farms #41

* Drillers Log *

Depth	Description of Formation or Sediment	Remarks
0	10	Red Clay
10	123	Sandy Brown Clay
123	142	Soft Brown Shale
142	360	Light Grey Granite

DIAGRAM
(NOT TO SCALE)

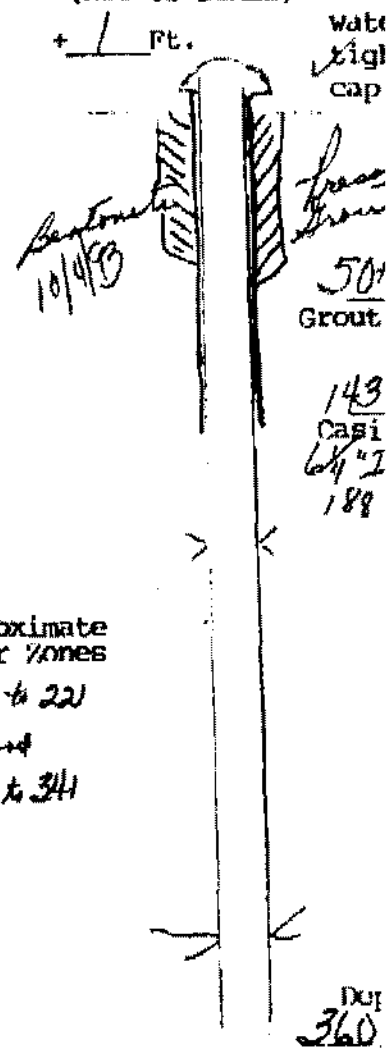

Approximate
Water Zones
220 to 221
and
340 to 341

(Use additional Sheets if necessary)

I certify that the information contained here is true and that this well was installed and constructed in accordance with the permit and applicable regulations, ordinances and laws.

Company: JOHN L. DANIELSON, JR., INC.
 Address: 4616 HOOD DRIVE
FREDERICKSBURG, VIRGINIA 22408
 Phone: (703) 898-6025 / 898-9355

Signature: *John L. Danielson, Jr.*
 Date: 10/17/73 Representing JOHN L. DANIELSON, JR., INC.

Professional License Number: CLASS A 2701 014084A II/H WVC