

WATER WELL COMPLETION REPORT

• BWCM No. _____

(Certification of Completion/County Permit)

Water Control Board
Box 11143
11 North Hamilton St.
Richmond, Va. 23230

County/City _____

Stafford

County/City Stamp

SWCB Permit _____
County Permit _____
Certification of inspecting official: This well does _____ does not _____ meet code/low requirements. S. _____ Date _____
For Office Use 25C-1-6

• Virginia Plane Coordinates	N _____
	E _____
Latitude & Longitude	N _____
	W _____
• Topo. Map No. _____	
• Elevation _____ ft.	
• Formation _____	
• Lithology _____	
• River Basin _____	
• Province _____	
• Type Logs _____	
• Cuttings _____	
• Water Analysis _____	
• Aquifer Test _____	

• Owner Richard Hayes

• Well Designation or Number _____

Address P.O. Box 8 Hartwood Va 22471

Phone 752-2223

• Drilling Contractor P. L. Curtis Well Co

Address P.O. Box 165
Bealton Va

Phone 439-8377

Tax Map I.D. No. <u>189-89-75</u>
Subdivision <u>Blake Farm</u>
Section <u>1</u>
Block _____
Lot <u>6</u>
Class Well: I _____, IIA _____
IIA <input checked="" type="checkbox"/> , IIIA _____, IIIB _____
IIIC _____, IIID _____, IIIE _____

WELL LOCATION: _____ (feet/miles _____ direction) of _____
and _____ (feet/miles _____ direction) of _____
(If possible please include map showing location marked)

Date started 10/2/89 • Date completed 10/2/89 Type rig air

1. WELL DATA: New Reworked _____ Deepened _____

• Total depth 205 ft.

• Depth to bedrock 100 ft.

• Hole size (Also include reamed zones)

• 10 inches from 0 to 110 ft.

• 6 inches from 110 to 205 ft.

• _____ inches from _____ to _____ ft.

• Casing size (I.D.) and material

• 6 inches from 0 to 110 ft.

Material Steel

Wt. per foot 13 or wall thickness 188 in.

• _____ inches from _____ to _____ ft.

Material _____

Wt. per foot _____ or wall thickness _____ in.

• _____ inches from _____ to _____ ft.

Material _____

Wt. per foot _____ or wall thickness _____ in.

• Screen size _____ mesh for each _____ (where applicable)

• _____ inches from _____ to _____ ft.

• Mesh size _____ Type _____

• _____ inches from _____ to _____ ft.

• Mesh size _____ Type _____

• _____ inches from _____ to _____ ft.

• Mesh size _____ Type _____

• _____ inches from _____ to _____ ft.

• Mesh size _____ Type _____

• Gravel pack

• From _____ to _____ ft.

• From _____ to _____ ft.

• Grout

• From 0 to 50 ft., Type Pressed

• From _____ to _____ ft., Type _____

2. WATER DATA • Water temperature _____ OF

• Static water level (unpumped level-measured) 31 ft.

• Stabilized measured pumping water level 204 ft.

• Stabilized yield 6 gpm after 4 hours

Natural Flow: Yes _____ No _____ flow rate _____ gpm

Comment on quality _____

3. WATER ZONES: From _____ To _____

From _____ To _____ From _____ To _____

From _____ To _____ From _____ To _____

4. USE DATA:

Type of use: Drinking Livestock Watering _____

Irrigation _____ Food processing _____ Household

Manufacturing _____ Fire safety _____ Cleaning _____

Recreation _____ Aesthetic _____ Cooling or heating _____

Injection _____ Other _____

• Type of facility: Domestic Public water supply _____

Public institution _____ Farm _____ Industry _____

Commercial _____ Other _____

5. PUMP DATA: Type _____ • Rated H.P. _____

• Intake depth _____ • Capacity _____ at _____ head

6. WELLHEAD: Type well seat _____

Pressure tank _____ gal., Loc. _____

Sample tap _____ Measurement port _____

Well vent _____ Pressure relief valve _____

Gate valve _____ Check valve (when required) _____

Electrical disconnect switch on power supply _____

7. DISINFECTION: Well disinfected _____ yes _____ no _____


Date _____ Disinfectant used _____

Amount _____ Hours used _____

8. ABANDONMENT (where applicable) • yes _____ no _____

Casing pulled yes _____ no _____ not applicable _____

Plugging grout From _____ to _____ material _____

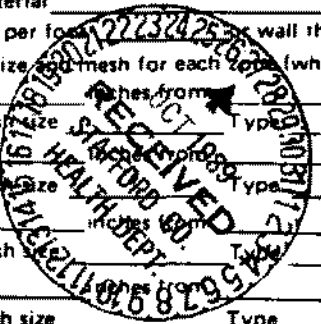

9. State law requires submitting to the Virginia State Water Control Board information about groundwater and wells for every well made in the State intended for water, or any other non-exempt well. This information must be submitted whether the well is completed, on standby, or abandoned. Information required includes: an accurately and completely prepared water well completion report, full data from any aquifer pumping tests, drill cuttings taken at ten foot intervals (unless exemption is secured), the results of any chemical analyses, and copies of any geophysical logs. Quarterly pumpage and use reports are required from owners of public supply and industrial wells. County or State permits to drill may be required in some parts of the state. Some counties require submission of a water well completion report. The Virginia State Health Department requires a water well completion report for public supply wells.


10. DRILLERS LOG (use additional Sheets if necessary)

DEPTH (feet)		TYPE OF ROCK OR SOIL (color, material, fossils, hardness, etc.)	REMARKS (water, caving, cavities, broken, core, shot, etc.)
From	To		
0	100	Sandy soil	
100	205	Sand stone	

11. Drilling Time (Min.)

12. DIAGRAM OF WELL CONSTRUCTION (with dimensions)

Well 205 ft
110 ft casing
50 ft grout

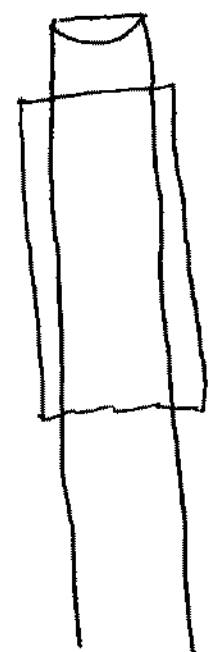

13. Well lot dedicated? _____; Size _____ ft. X _____ ft.; Well house? _____
 Distance to nearest pollutant source _____ ft., Type _____
 Distance to nearest property line _____ ft., Building _____ ft.

14. WATER SERVICE PIPE: Checked under _____ p.s.i. for _____ minutes. Pipe size _____ inches, Material _____
 Installer _____
 Date _____

State Water Control Board Regional Offices

Valley Reg. Off.
116 North Main Street
P. O. Box 268
Bridgewater, Va. 22812
703-828-2595

Piedmont Reg. Off.
4010 West Broad Street
P. O. Box 6616
Richmond, Va. 23230
804-257-1006

Southwest Reg. Off.
408 East Main Street
P. O. Box 476
Abingdon, Va. 24210
703-628-5183

Tidewater Reg. Off.
287 Pembroke Office Park
Suite 310 Pembroke No. 2
Va. Beach, Va. 23462
804-499-8742

West Central Reg. Off.
Executive Park
5312 Peters Creek Road
Roanoke, Va. 24019
703-982-7432

Northern Virginia Reg. Off.
5515 Cherokee Avenue
Suite 404
Alexandria, Va. 22312
703-750-9111

15. I certify that the information contained herein is true and correct and that this well and/or system has been installed and constructed in accordance with the requirements for well construction as specified in compliance with appropriate county or independent city ordinances and the laws and rules of the Commonwealth of Virginia.

Signature Raymond L. Curtis (Seal), Date 10/12/89
 (Well Driller or authorized person) License No. _____