

COMMONWEALTH OF VIRGINIA
WATER WELL COMPLETION REPORT

BWCM No. _____

(Certification of Completion/County Permit)

25-1A-44

Water Control Board
Box 11143
111 North Hamilton St.
Richmond, Va. 23230

Coale Builders
2803 Jefferson Davis Highway
Stafford Va. 22554
257-1063

SWCB Permit _____
County Permit _____
Certification of inspecting official:
This well does _____ does not _____
meet code/low requirements.
S _____
Date _____

For Office Use

County/City Stafford

County/City Stamp

Virginia Plane Coordinates
N _____
E _____
Latitude & Longitude
N _____
W _____
Topo. Map No. 183D
Elevation _____ ft.
Formation _____
Lithology _____
River Basin _____
Province _____
Type Logs L. L.
Cuttings N. A.
Water Analysis _____
Aquifer Test _____

Owner For Sale
Well Designation or Number _____
Address _____
Phone _____
Drilling Contractor John L. Danielson, Jr., Inc.
Address 4616 Hood Drive
Fredericksburg, Virginia 22401
Phone (703) 898-6025

5D-86-456 Frank
Tax Map I.D. No. 25-1A-44
Subdivision King's Point
Section _____
Block _____
Lot 44
Class Well I _____ IIA _____
IIB _____ IIA _____ IIB
IIC _____ IID _____ IIE _____

WELL LOCATION: 1 1/2 miles S (direction) of intersection of 614 + 615
and .3 miles E (direction) of 615
(If possible please include map showing location marked)
Water rose 4 ft. in 30 min. time of installation.
24" I.D. casing holds 23.5 gal. of water per foot.
Date started 10-6-87 Date completed 10-6-87 Type of boring rig _____

Approximate Drawdown 20 ft.

1. WELL DATA: New Reworked _____ Deepened _____
Total depth 41 ft.
Depth to bedrock 41 ft. (on Rock)
Hole size (Also include reamed zones)
• 39 inches from 0 to 30 ft.
• 29 inches from 20 to 41 ft.
• _____ inches from _____ to _____ ft.
Casing size (I.D.) and material
• 24 inches from +1 to 41 ft.
Material cement Concrete Casing
Wt. per foot _____ or wall thickness _____ in.
• _____ inches from _____ to _____ ft.
Material _____
Wt. per foot _____ or wall thickness _____ in.
• _____ inches from _____ to _____ ft.
Material _____
Wt. per foot _____ or wall thickness _____ in.
Screen size and mesh for each zone (where applicable)
• _____ inches from _____ to _____ ft.
• Mesh size _____ Type _____
• _____ inches from _____ to _____ ft.
• Mesh size _____ Type _____
• _____ inches from _____ to _____ ft.
• Mesh size _____ Type _____
• _____ inches from _____ to _____ ft.
• Mesh size _____ Type _____
Gravel pack
• From _____ to _____ ft.
• From _____ to _____ ft.
Grout
• From _____ to _____ ft. Type _____
• From _____ to _____ ft. Type _____

2. WATER DATA • Water temperature _____ °F
Static water level (unpumped level measured) 15 ft.
Stabilized measured pumping water level 35 ft.
Stabilized yield 2.5 gpm after _____ hours of operation
Natural Flow Yes _____ No flow rate _____ gpm
Comment on quality _____
3. WATER ZONES: From 15 To 25
From 25 To 41 From _____ To _____
From _____ To _____ From _____ To _____
4. USE DATA:
Type of use: Drinking Livestock Watering _____
Irrigation _____ Food processing _____ Household
Manufacturing _____ Fire safety _____ Cleaning _____
Recreation _____ Aesthetic _____ Cooling or heating _____
Injection _____ Other _____
Type of facility: Domestic Public water supply _____
Public institution _____ Farm _____ Industry _____
Commercial _____ Other _____

5. PUMP DATA: Type _____ Rated H.P. _____
Intake depth _____ Capacity _____ at _____ head
6. WELLHEAD: Type well seal _____
Pressure tank _____ gal. Loc. _____
Sample tap _____ Measurement port _____
Well vent _____ Pressure relief valve _____
Gate valve _____ Check valve (when required) _____
Electrical disconnect switch on power supply _____


7. DISINFECTION: Well disinfected _____ yes _____ no _____
Date _____ Disinfectant used _____
Amount _____ Hours used _____

8. ABANDONMENT (where applicable) • yes _____ no _____
Casing pulled yes _____ no _____ not applicable _____
Plugging grout From _____ to _____ material _____
Pump installation through Coale Builders

Ernest Backfill - Drilling &

OVER

JOHN L. DANIELSON, JR., INC.
Drilled & Bored Wells
4616 Hood Drive
FREDERICKSBURG, VIRGINIA 22401

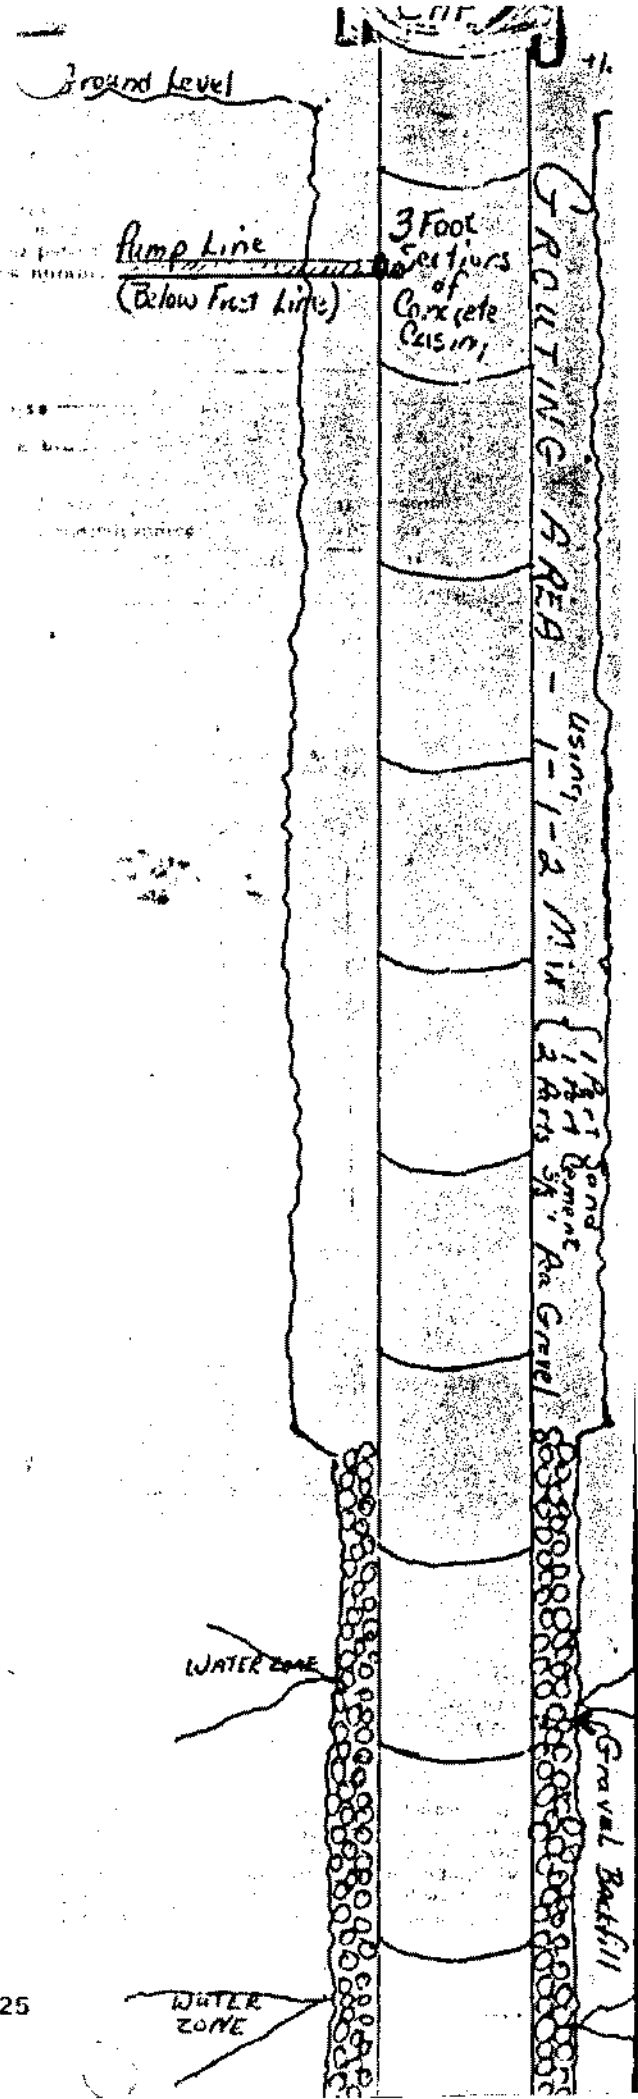

Phone 898-WELL or 898-6025