

COMMONWEALTH OF VIRGINIA
WATER WELL COMPLETION REPORT

•BWCM No. _____


(Certification of Completion/County Permit)

25-25

Control Board
1143
11th Hamilton St.
Richmond, Va. 23230

County/City Stafford

County/City Stamp

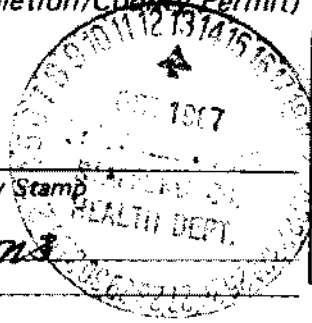

SWCB Permit _____
County Permit _____
Certification of inspecting official:
This well does _____ does not _____
meet code/low requirements.
S. _____
Date _____
For Office Use

• Virginia Plane Coordinates
N _____
E _____
Latitude & Longitude
N _____
W _____
• Topo. Map No. _____
• Elevation _____ ft.
• Formation _____
• Lithology _____
• River Basin _____
• Province _____
• Type Logs Driller
• Cuttings no
• Water Analysis _____
• Aquifer Test _____

• Owner V.R. Timmons
• Well Designation or Number _____
Address Stafford, Va
Phone _____

• Drilling Contractor
Address KING GEORGE DRILLING SERVICES, INC
RT. 1 BOX 117
Phone COLONIAL BEACH, VA. 22449

WELL LOCATION: 1 (miles) EAST (direction) of Rt 67
and 1/10 (miles) SW (direction) of Rt 649
(If possible please include map showing location marked)

Tax Map I.D. No. _____
Subdivision _____
Section _____
Block _____
Lot _____
Class Well I _____, IIA _____
IIB _____, IIIA _____, IIIB
IIIC _____, IIID _____, IIIE _____

Date started 8-10-87 • Date completed 8-10-87 Type rig Gus Pack

1. WELL DATA: New Reworked _____ Deepened _____
• Total depth 46 ft.
• Depth to bedrock _____ ft.
• Hole size (Also include reamed zones)
• 44 inches from 0 to 20 ft.
• 46 inches from 20 to 46 ft.
• _____ inches from _____ to _____ ft.
• Casing size (I.D.) and material
• 30 inches from _____ to _____ ft.
Material Concrete
Wt. per foot _____ or wall thickness 2 in.
_____ inches from _____ to _____ ft.
Material _____
Wt. per foot _____ or wall thickness _____ in.
_____ inches from _____ to _____ ft.
Material _____
Wt. per foot _____ or wall thickness _____ in.
• Screen size and mesh for each zone (where applicable)
• _____ inches from _____ to _____ ft.
• Mesh size _____ Type _____
• _____ inches from _____ to _____ ft.
• Mesh size _____ Type _____
• _____ inches from _____ to _____ ft.
• Mesh size _____ Type _____
• _____ inches from _____ to _____ ft.
• Mesh size _____ Type _____
• Gravel pack
• From 20 to 40 ft.
• From _____ to _____ ft.
• Grout
• From 0 to 20 ft., Type Cement
• From _____ to _____ ft., Type _____

2. WATER DATA • Water temperature _____ of _____
• Static water level (unpumped level measured) 18 ft.
• Stabilized measured pumping water level 26 ft.
• Stabilized yield 1/2 gpm after 4 hours
Natural Flow: Yes _____ No _____ flow rate _____ g pm
Comment on quality good
3. WATER ZONES: From 20 To _____
From _____ To _____ From _____ To _____
From _____ To _____ From _____ To _____
4. USE DATA:
Type of use: Drinking Livestock Watering _____
Irrigation _____ Food processing _____ Household
Manufacturing _____ Fire safety _____ Cleaning _____
Recreation _____ Aesthetic _____ Cooling or heating _____
Injection _____ Other _____
• Type of facility: Domestic Public water supply _____
Public institution _____ Farm _____ Industry _____
Commercial _____ Other _____
5. PUMP DATA: Type Sub • Rated H.P. 1/2
• Intake depth 43 • Capacity _____ at _____ head
6. WELLHEAD: Type well seat Concrete cap
Pressure tank 20 gal., Loc. well
Sample tap Measurement port
Well vent Pressure relief valve
Gate valve Check valve (when required)
Electrical disconnect switch on power supply
7. DISINFECTION: Well disinfected yes _____ no _____
Date 8-10-87 Disinfectant used chlorine
Amount 50 PPM Hours used 24
8. ABANDONMENT (where applicable) • yes _____ no _____
Casing pulled yes _____ no _____ not applicable _____
Plugging grout From X to _____ material _____

111 North Main Street
 Richmond, Va. 23220
 State Water Control Board

9. State law requires submitting to the Virginia State Water Control Board information about groundwater and wells for every well back-siphonage intended for water, or any other non-exempt well. This information must be submitted whether the well is completed, on standby, or abandoned. Information required includes: an accurately and completely prepared water well completion report, full data from any water pumping test, cuttings taken at ten foot intervals (unless exemption is secured), the results of any chemical analyses, and copies of any geophysical logs. Quarterly pumpage and use reports are required from owners of public supply and industrial wells. County or State permits to drill may be required in some parts of the state. Some counties require submission of a water well completion report. The Virginia State Health Department requires a water well completion report for public supply wells.

10. DRILLERS LOG (use additional Sheets if necessary)

DEPTH (feet)			TYPE OF ROCK OR SOIL (color, material, fossils, hardness, etc.)	REMARKS (water, caving, cavities, broken, core, shot, (etc.))	11. Drilling Time (Min.)
From	To				
0	2		TOP SOIL		
2	45		Br white sand mica & soap stone		
45	46		rock		

12. DIAGRAM OF WELL CONSTRUCTION (with dimensions)

13. Well lot dedicated? _____; Size _____ ft. X _____ ft.; Well house? _____
 Distance to nearest pollutant source _____ ft., Type _____
 Distance to nearest property line _____ ft., Building _____ ft.

14. WATER SERVICE PIPE: Checked under _____ p.s.i. for _____ minutes. Pipe size _____ inches, Material _____
 Installer _____
 Date _____

15. I certify that the information contained herein is true and correct and that this well and/or system has been installed and constructed in accordance with the requirements for well construction as specified in compliance with appropriate county or independent city ordinances and the laws and rules of the Commonwealth of Virginia.

Signature C. E. Kealey (Seal), Date 8-12-87
 (Well driller or authorized person)
 License No. 1A023065
MD-299

State Water Control Board Regional Offices

Valley Reg. Off.
 116 North Main Street
 P. O. Box 268
 Bridgewater, Va. 22812
 703-828-2595

Piedmont Reg. Off.
 4010 West Broad Street
 P. O. Box 6616
 Richmond, Va. 23230
 804-257-1006

Southwest Reg. Off.
 408 East Main Street
 P. O. Box 476
 Abingdon, Va. 24210
 703-628-5183

Tidewater Reg. Off.
 287 Pembroke Office Park
 Suite 310 Pembroke No. 2
 Va. Beach, Va. 23462
 804-499-8742

West Central Reg. Off.
 Executive Park
 5512 Peters Creek Road
 Roanoke, Va. 24019
 703-982-7432

Northern Virginia Reg. Off.
 5515 Cherokee Avenue
 Suite 404
 Alexandria, Va. 22312
 703-750-9111