

Lois Tenderwood, lot 9874
 Address 1213 Hardwood Road
Hardwood, Va. 22406
 Phone 752-4329
 Location R. 2412 -> L. on 614 Property on left - Powerline
157 Spotted Fern Rd

Tax Map ID 25-36-B
 VDH Permit SW-94-217
 VWCB Permit _____
 VWCB ID _____
 County Stafford
8/17/94 Wadton Wright

Well Classification IITA IIIR IIIC IV
 * Well Data *

General Information

Drilling Method Case Rotary
 Depth to Bedrock 77
 Static Water Level 60'
 Well Disinfected (Y or N) _____

Date Completed 12/16/94
 Yield 25 (GPM)
 Stabilized Water 100
 Disinfectant Used _____

Total Depth of Well 160'
 Length of Test approx 1 Hr.
 Natural Flow (Rate) _____
 Amount Used _____

Casing:
 From +1 To 77
 Size 6 1/2 Material PVC
 Weight/Schedule SPR 27

From 70 To 120
 Size 4" Material P.V.C.
 Weight/Schedule Sch 40

From 140 To 160
 Size 4" Material P.V.C.
 Weight/Schedule Sch 40

Gravel Pack

From _____ To _____
 Hole size _____
10' from 0 to 55ft.
 Grout _____
 From 0 To 50'
 Bore Hole Size 10" 12/29/94
 Type Bentonite
 Method Pneum. Grouting

From _____ To _____
7 1/8" FROM 55 to 77 ft.
 From _____ To _____
 Bore Hole Size _____
 Type _____
 Method _____

From _____ To _____
6 1/8" FROM 77 to 160ft.
 From _____ To _____
 Bore Hole Size _____
 Type _____
 Method _____

Water Zones or Screened Intervals
 From 120 To 140
 Mesh Size 20 Diam 4" P.V.C.
 From _____ To _____
 Mesh Size _____ Diam _____

approx water zones
 From 130 To 131
 Mesh Size _____ Diam _____
 From _____ To _____
 Mesh Size _____ Diam _____

From _____ To _____
 Mesh Size _____ Diam _____
 From _____ To _____
 Mesh Size _____ Diam _____

* Use Data *

Private Well: Domestic Agricultural _____ Industrial _____ Monitoring _____
 Public Well: Community _____ Non Community _____

3/4 H.P. 10 GPM Red Ticker
WX 250

* Abandonment Information *

Bored or Dug Wells
 Casing Removed, Y or N? _____
 If Y, Depth to which casing was removed: _____
 Depth and Type of Fill: _____
 Source of Fill _____
 Bentonite Plugs: From _____ to _____ From _____ to _____

Wells other than Bored Wells
 Casing removed, Y or N? _____
 Depth to which casing was removed: _____
 Applicable, depth(s), and type of gravel/sand fill: _____
 Source of gravel or sand: _____
 Cement: From _____ to _____ From _____ to _____


Serial #
Pump 0411018
Motor 0411019

Method of permanently marking location: _____

Installed watertight top
 Suggest setting pump @ approx 120 Ft.
top will approximately 4' casing @ approx 70.
Suggest keeping torque wrenches & centralizers out of 4" cas
943258
137 S. 1st St. Fairfax Rd.

137 Spotted Tavern Rd
 17 → Run #612 → L. on #614
 Property on left - lower line
 Drillers Log

Depth	Description of Formation or Sediment	Remarks
0	10 Red Clay	
10	30 Micaceous formation / Red	
30	60 Micaceous formation / Brown	
60	77 Brown Shale	set 4" P.V.C. well casing + screen due to the softness of the formation
77	160 Blue Shale	

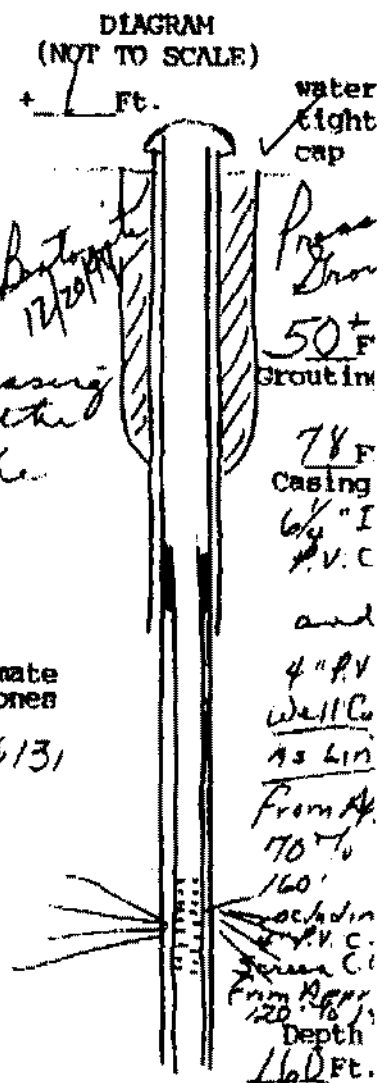

Approximate
 Water Zones
 130' to 131'

(Use additional Sheets if necessary)

I certify that the information contained here is true and that this well was installed and constructed in accordance with the permit and further that the well complies with all applicable state and local regulations, ordinances and laws

Name JOHN L. DANIELSON, JR., INC.
 Address 4515 HOOD DRIVE
FREDERICKSBURG, VIRGINIA 22408
 Phone (703) 898-6025 / 898-9355
 Drillers Signature John L. Danielson, Pres
 Date 12/20/97 representing JOHN L. DANIELSON, JR., INC.
 Virginia Contractors License Number CLASS A 2701 014084A II/H WVC