

FD-202 (Rev. 12-1988)

COMMONWEALTH OF VIRGINIA
WATER WELL COMPLETION REPORT

BWCBM No. _____

(Certification of Completion/County Permit)

State Water Control Board
P. O. Box 12142
2111 Harris Boulevard St.
Richmond, Va. 23220

County/City STAFFORD

County/City Stamp

Virginia Plane Coordinates

Latitude & Longitude

Topo. Map No.

Elevation _____ ft.

Formation _____

Lithology _____

Riser Base _____

Province _____

Type Log _____

Cuttings _____

Water Analysis _____

Acquifer Test _____

Owner Robert Holloman

Well Designation or Number SWP-00-001

Address 1987 QUINCY ST
LINDSEY PIA

Phone 914-822-1522

Drilling Contractor CURTIS BROS. DRILLING & PUMP SERVICE LLC

Address 8908 SURREYDICK RD.
SURREYDICK VA 22748

Phone 540-438-8377

BWCB Permit

County Permit

Certification of installing official:

This well does _____

meet applicable requirements.

By _____

Date _____

For Office Use

Tax map I.C. No. 25D-4

Subdivision THURGOOD RIDGE

Section _____

Block _____

Lot 4

Class Map: I _____ IIIA _____ IIIB III C _____

25D-1-4

WELL LOCATION: _____

and _____

Date started 1/12/00 Date completed 1/15/00 Type of Air

WELL DATA: New Rerigged _____ Disposed _____

Total depth 125 ft.

Depth to bedrock 40 ft.

Hole size (Also include reamed count)

10 inches from 0 to 55 ft.

6 inches from 55 to 125 ft.

casing size (I.D.) and material

4.75 inches from 0 to 55 ft.

Material PURSIC

wt. per foot _____ or wall thickness 0.44 in.

Screen size and mesh for each zone (where applicable)

0 inches from _____ to _____ ft.

Mesh size _____ Type _____

0 inches from _____ to _____ ft.

Mesh size _____ Type _____

0 inches from _____ to _____ ft.

Mesh size _____ Type _____

0 inches from _____ to _____ ft.

Mesh size _____ Type _____

Gravel pack

From _____ to _____ ft.

From _____ to _____ ft.

Grout

From 0 to 55 ft. Type PRESSURE

From _____ to _____ ft. Type _____

2. WATER DATA: Water temperature _____ °F

Static water level (unpumped level-measured) 30 ft.

Estimated measured pumping water level 125 ft.

Estimated yield _____ gpm after _____ hours

Normal Flow: Yes _____ No _____ Flow rate _____ gpm

Comments on quality _____

2. WATER ZONES: From _____ To _____

From _____ To _____

From _____ To _____

4. USE DATA:

Type of use: Drinking Livestock Watering _____

Irrigation _____ Food Processing _____

Manufacturing _____ Fire Safety _____

Recreation _____ Aesthetic _____

Injection _____ Other _____

Type of facility: Domestic Public water supply _____

Public Institution _____ Farm _____

Commercial _____ Other _____

5. PUMP DATA: Type _____

6. WELLHEAD: Type _____

Pressure tank _____

Sample tap _____

Well vent _____

Gas valve _____

Electrical equipment _____

7. OBSERVATION: Well disinfection _____

Date _____

8. ABANDONMENT (where applicable):

Casing pulled _____


Plugging grout _____

DWFR

2. State law requires information to the Virginia State Water Control Board information about groundwater and wells for every well made in the State including for water, or any other non-potable well. This information shall be collected whether the well is completed, or existing, or abandoned. Information required includes an accurately and completely prepared well completion report, test data from any suitable pumping test, and pumping data as the test proceeds, finished construction is situated, the status of any completed test, and copies of any geophysical logs. Geophysical pumping test data reports are required from owners of private supply and industrial wells. Copies of State permits to drill may be required in some parts of the State. State agencies require submission of a water well completion report. The Virginia State Water Control Board requires a copy with completion report for public supply wells.

14. DRAINAGE LOG (See attached Sheet 2 required)

14. DRAINAGE LOG (See attached Sheet 2 required)		15.	16. DRAINAGE OF WELL CONSTRUCTION (See attached)
DEPTH (Feet)	TYPE OF SOIL OR ROCK (Sand, silt, clay, gravel, etc.)	THICKNESS (Feet)	
0 - 40	Red soil		Well 325 FT CASING 55 FT GROUT 55 FT WATER TIGHT CAP
40 - 325	Blue shale		

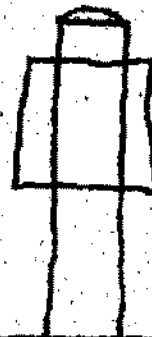

15. WATER DEPTH? _____ ft. W. Well depth? _____ ft.
 Distance to nearest public supply _____ ft. Type _____
 Distance to nearest primary line _____ ft. Building _____ ft.

16. WATER SERVICE PIPE: Character _____ P.S.I. for _____
 Material _____
 Size _____

18. I hereby state the information furnished herein is true and correct and that this well complies with the design and construction as indicated on the drawings and the requirements for well construction as specified in compliance with appropriate State or Federal law or regulation and the laws and rules of the Commonwealth of Virginia.

State Water Control Board Regional Offices

Water Reg. Off.
 110 North Main Street
 P. O. Box 200
 Charlottesville, Va. 22902
 703-625-0995

Richmond Reg. Off.
 400 East Main Street
 P. O. Box 375
 Richmond, Va. 23202
 703-625-0122


West Central Reg. Off.
 Executive Park
 2010 South Creek Road
 Lynchburg, Va. 24515
 703-625-7482

Roanoke Reg. Off.
 600 West Broad Street
 P. O. Box 6400
 Roanoke, Va. 24006
 540-957-1000

Tidewater Reg. Off.
 607 Riverside Drive
 South 140 Westgate Ave. E
 Va. Beach, Va. 23060
 810-676-0747

Northern Virginia Reg. Off.
 6610 Clarendon Avenue
 Suite 404
 Arlington, Va. 22204
 703-706-0111

Signature Robert McMillan Date _____
 Title _____ or authorized person License No. 02422011

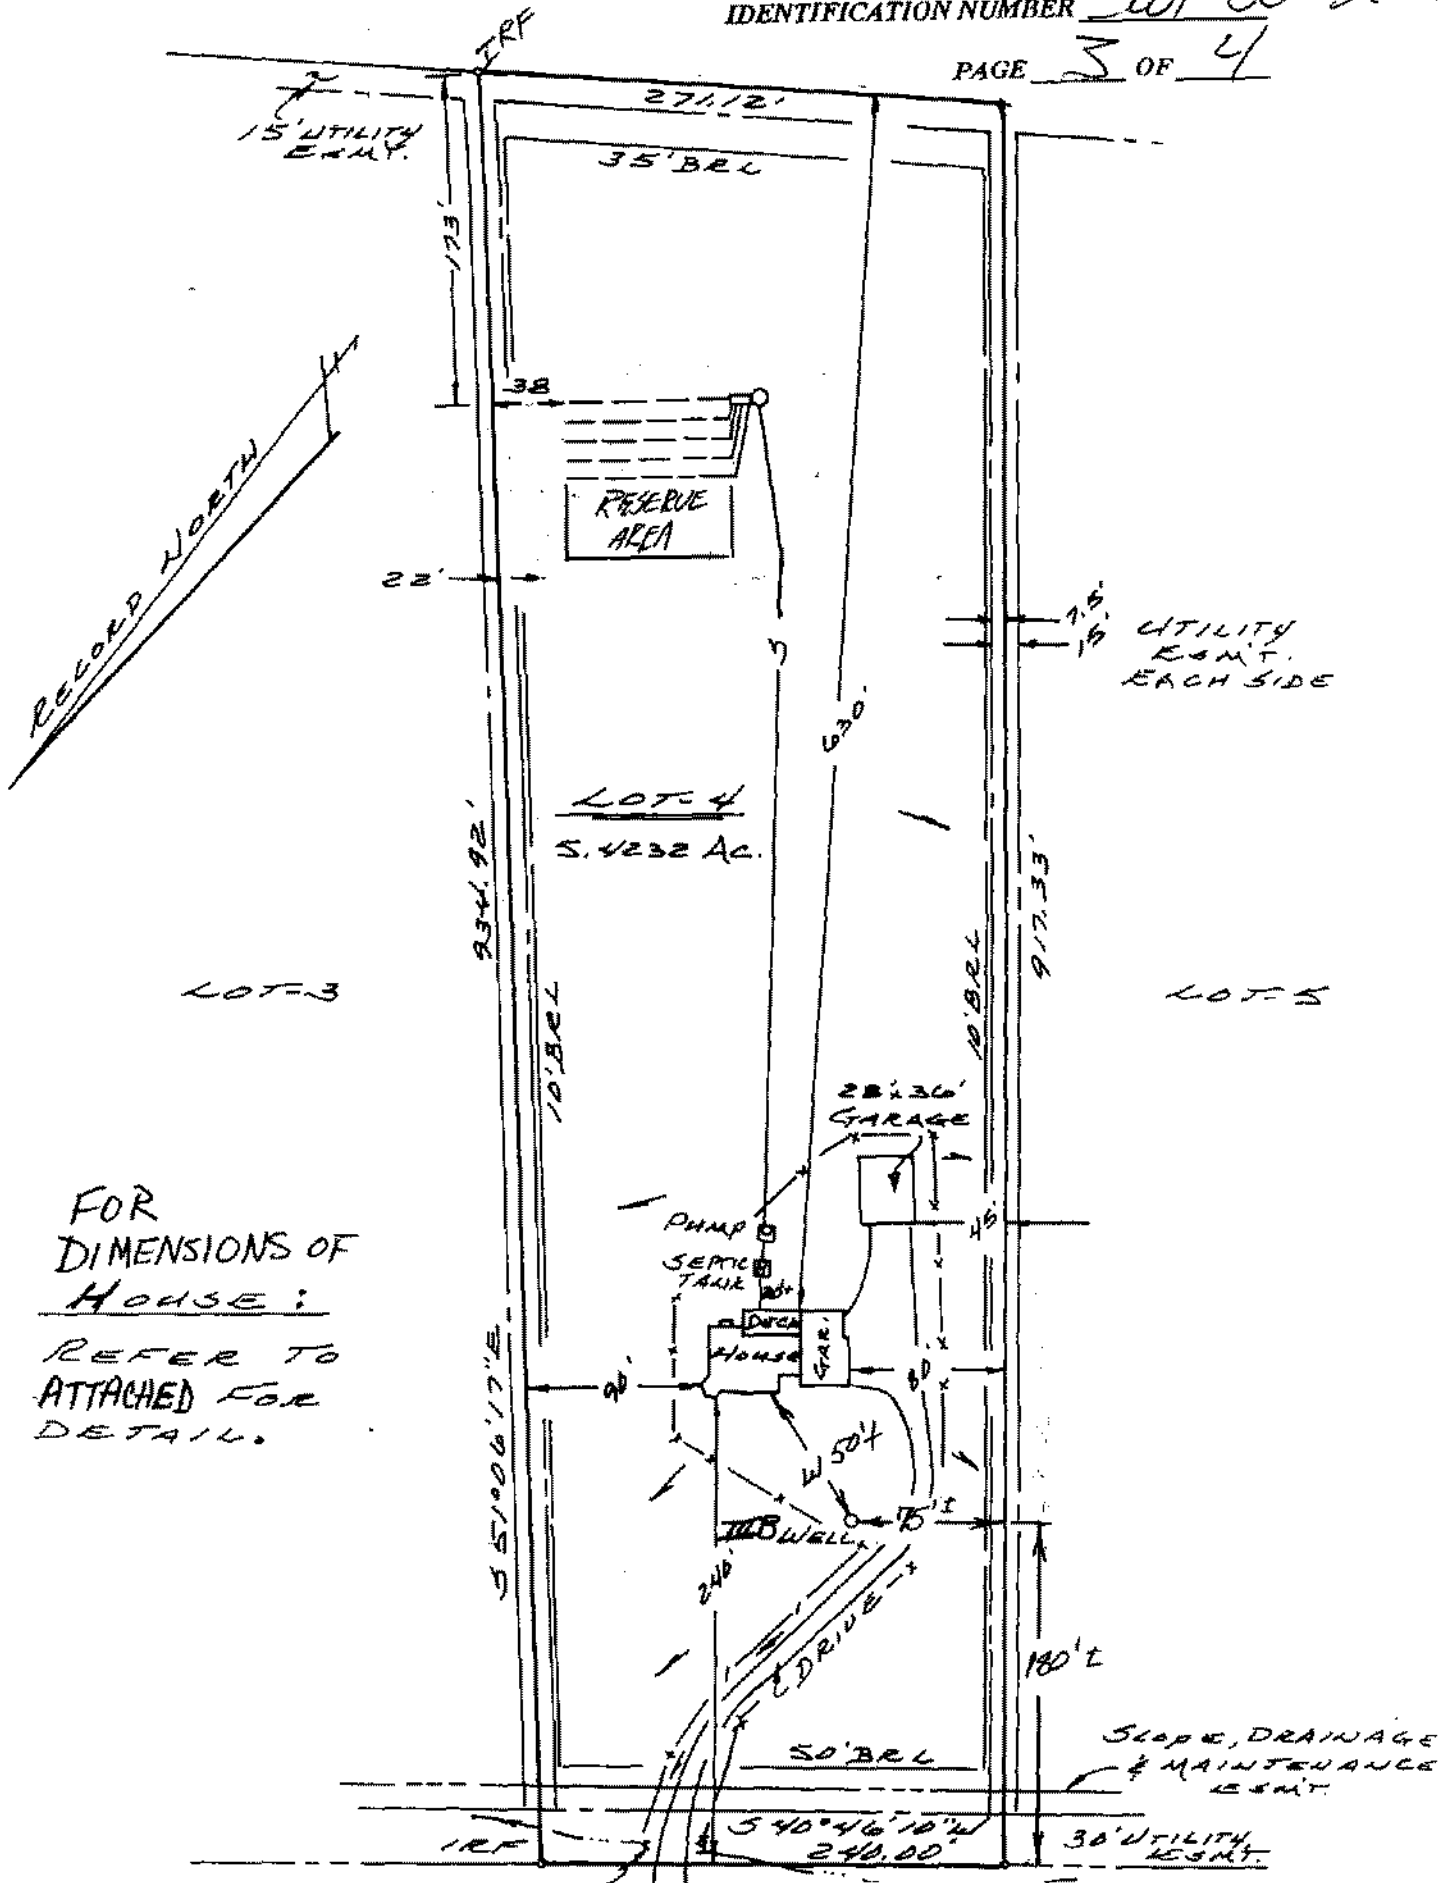

FOR
DIMENSIONS OF
HOUSE:
REFER TO
ATTACHED FOR
DETAILS.