

Munday  
90 E River Bend Road  
Friederickburg, VA 22407  
786-6538 fax 786-0733

Commonwealth of Virginia  
Uniform Water Well Completion Report

Owner David & Rebecca Brooks  
Address 110 River View  
Friederickburg VA  
Phone 371-5801  
Location Timberidge #9

Tax Map ID 25 D+9  
VDH Permit SWP-00-364  
VWCB Permit \_\_\_\_\_  
VWCB ID \_\_\_\_\_  
County Stafford  
9/21/00 Ashton Wright  
DJC

Well Classification IIIA \_\_\_\_\_ IIIB \_\_\_\_\_ IIIC \_\_\_\_\_ IV \_\_\_\_\_  
\* Well Data \*

General Information  
Drilling Method Air Rotary  
Depth to Bedrock 55  
Static Water Level 30'  
Well Disinfected (Y or N) \_\_\_\_\_

Date Completed 1/25/2001  
Yield 5 (GPM)  
Stabilized Water Level 280'  
Disinfectant Used \_\_\_\_\_

Total Depth of Well 340  
Length of Test approx 1 Hr  
Natural Flow (Rate) \_\_\_\_\_  
Amount Used \_\_\_\_\_

Casing  
From 11 To 83  
Size 4" Material PVC  
Weight/Schedule SDR 27

From 60 To 300  
Size 4" Material PVC  
Weight/Schedule Sch 40

From 320 To 340  
Size 4" Material PVC  
Weight/Schedule Sch 40

Gravel Pack  
From \_\_\_\_\_ To \_\_\_\_\_

From \_\_\_\_\_ To \_\_\_\_\_

From \_\_\_\_\_ To \_\_\_\_\_

Hole size  
" from \_\_\_\_\_ to \_\_\_\_\_ ft.

" from \_\_\_\_\_ to \_\_\_\_\_ ft.

" from \_\_\_\_\_ to \_\_\_\_\_ ft.

Grout  
From 0 To 60'  
Bore Hole Size 10"  
Type Bentonite  
Method Pressure Grouting

From \_\_\_\_\_ To \_\_\_\_\_  
Bore Hole Size \_\_\_\_\_  
Type \_\_\_\_\_  
Method \_\_\_\_\_

From \_\_\_\_\_ To \_\_\_\_\_  
Bore Hole Size \_\_\_\_\_  
Type \_\_\_\_\_  
Method \_\_\_\_\_

Water Zones or Screened Intervals

From 300 To 320  
Mesh Size 0.20 Diam 4" (P.V.C.)  
From \_\_\_\_\_ To \_\_\_\_\_  
Mesh Size \_\_\_\_\_ Diam \_\_\_\_\_

From 180 To 181  
Mesh Size \_\_\_\_\_ Diam \_\_\_\_\_  
From 310 To 311  
Mesh Size \_\_\_\_\_ Diam \_\_\_\_\_

From \_\_\_\_\_ To \_\_\_\_\_  
Mesh Size \_\_\_\_\_ Diam \_\_\_\_\_  
From \_\_\_\_\_ To \_\_\_\_\_  
Mesh Size \_\_\_\_\_ Diam \_\_\_\_\_

\* Use Data \*

Private Well: Domestic  Agricultural \_\_\_\_\_ Industrial \_\_\_\_\_ Monitoring \_\_\_\_\_  
Public Well: Community \_\_\_\_\_ Non Community \_\_\_\_\_

\* Abandonment Information \*

Bored or Dug Wells  
Casing Removed, Y or N?: \_\_\_\_\_  
If Y, Depth to which casing was removed: \_\_\_\_\_  
Depth and Type of Fill: \_\_\_\_\_  
Source of Fill: \_\_\_\_\_  
Bentonite Plugs: From \_\_\_\_\_ to \_\_\_\_\_ From \_\_\_\_\_ to \_\_\_\_\_

Wells other than Bored Wells  
Casing removed, Y or N? \_\_\_\_\_  
Depth to which casing was removed: \_\_\_\_\_  
Applicable, depth(s), and type of gravel/sand fill: \_\_\_\_\_  
Source of gravel or sand: \_\_\_\_\_  
Cement: From \_\_\_\_\_ to \_\_\_\_\_ From \_\_\_\_\_ to \_\_\_\_\_

Method of permanently marking location: \_\_\_\_\_  
 Installed watertight top  
Suggest setting pump @ approx. 300 ft.  
You will encounter 4" casing @ approx 60 ft.  
Suggest keeping venturizers & torque arrestors out of 4" casing.

James Zumba  
David & Rebecca Brooks  
Lumberidge # 9  
Stafford

\* Drillers Log \*

Depth

109 Lumberidge Drive


Description of Formation or Sediment

Remarks

0	10	Red Clay
10	130	Brown Shale
130	340	Grey Shale

set 4" P.V.C Well Casing & Screen - no liner - due to the softness of the formation

DIAGRAM (NOT TO SCALE)

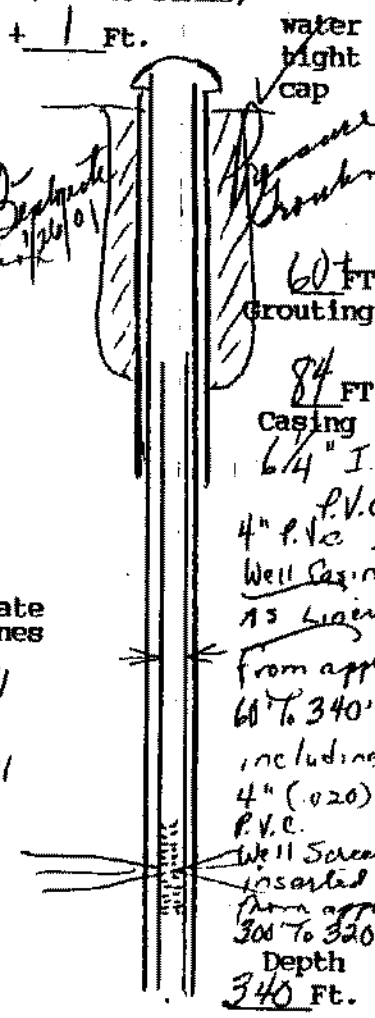

Approximate Water Zones

180 to 181  
 and  
 310 to 311

(User additional Sheets if necessary)

I certify that the information contained here is true and that this well was installed and constructed in accordance with the permit and further that the well complies with all applicable state and local regulations, ordinances and laws.

Name JOHN L. DANIELSON, JR., INC.  
 Address 4516 HOOD DRIVE  
FREDERICKSBURG, VIRGINIA 22408  
 Phone 540 (703) 898-8025 / 898-9355

Drillers Signature John L. Danielson, Jr. Pres  
 Date 1/26/200 Representing JOHN L. DANIELSON, JR., INC.

Virginia Contractors License Number CLASS A 2701 014084A II/II WVC

