

COMMONWEALTH OF VIRGINIA  
WATER WELL COMPLETION REPORT

\*BWCM No. \_\_\_\_\_

(Certification of Completion/County Permit)

State Water Control Board  
P. O. Box 11143  
2111 North Hamilton St.  
Richmond, Va. 23230

County/City STAFFORD

County/City Stamp

\*Virginia Plane Coordinates  
N \_\_\_\_\_  
E \_\_\_\_\_  
Latitude & Longitude  
N \_\_\_\_\_  
W \_\_\_\_\_  
\*Topo. Map No. \_\_\_\_\_  
\*Elevation \_\_\_\_\_ ft.  
\*Formation \_\_\_\_\_  
\*Lithology \_\_\_\_\_  
\*River Basin \_\_\_\_\_  
\*Province \_\_\_\_\_  
\*Type Logs \_\_\_\_\_  
\*Cuttings \_\_\_\_\_  
\*Water Analysis \_\_\_\_\_  
\*Aquifer Test \_\_\_\_\_

\*Owner Rick McMillion / SUNSHINE HOMES  
\*Well Designation or Number 25-34A-4  
Address P.O. Box 840 GARFIELDVILLE VA 22463  
Phone 659-1113

\*Drilling Contractor CURTIS BROS. DRILLING & PUMP SERVICE LLC  
Address 5069 SUMERDUCK RD. SUMERDUCK, VA 22742  
Phone 540-439-8377

WELL LOCATION: \_\_\_\_\_ (feet/miles \_\_\_\_\_ direction) of \_\_\_\_\_  
and \_\_\_\_\_ (feet/miles \_\_\_\_\_ direction) of \_\_\_\_\_  
(If possible please include map showing location marked)  
Date started 12/14/01 \* Date completed 12/14/01 Type rig AIR

SWCB Permit \_\_\_\_\_  
County Permit \_\_\_\_\_  
Certification of inspecting official:  
This well does \_\_\_\_\_ does not \_\_\_\_\_  
meet code/low requirements.  
S. \_\_\_\_\_  
Date \_\_\_\_\_  
For Office Use

Tax Map I.D. No. 25-34A-4  
Subdivision LEONARD KROLL  
Section \_\_\_\_\_  
Block \_\_\_\_\_  
Lot 4  
Class Well: I \_\_\_\_\_ IIA \_\_\_\_\_  
IIB \_\_\_\_\_ IIIA \_\_\_\_\_ IIIB   
IIIC \_\_\_\_\_ IIID \_\_\_\_\_ IIIE \_\_\_\_\_

1. WELL DATA: New  Reworked \_\_\_\_\_ Deepened \_\_\_\_\_  
\*Total depth 145 ft.  
\*Depth to bedrock 70 ft.  
\*Hole size (Also include reamed zones)  
• 10 inches from 0 to 80 ft.  
• 6 inches from 80 to 145 ft.  
• \_\_\_\_\_ inches from \_\_\_\_\_ to \_\_\_\_\_ ft.  
\*Casing size (I.D.) and material  
• 6 1/2 inches from 0 to 80 ft.  
Material Plastic  
Wt. per foot 4 or wall thickness 244 in.  
• \_\_\_\_\_ inches from \_\_\_\_\_ to \_\_\_\_\_ ft.  
Material \_\_\_\_\_  
Wt. per foot \_\_\_\_\_ or wall thickness \_\_\_\_\_ in.  
• \_\_\_\_\_ inches from \_\_\_\_\_ to \_\_\_\_\_ ft.  
Material \_\_\_\_\_  
Wt. per foot \_\_\_\_\_ or wall thickness \_\_\_\_\_ in.  
\*Screen size and mesh for each zone (where applicable)  
• \_\_\_\_\_ inches from \_\_\_\_\_ to \_\_\_\_\_ ft.  
\*Mesh size \_\_\_\_\_ Type \_\_\_\_\_  
• \_\_\_\_\_ inches from \_\_\_\_\_ to \_\_\_\_\_ ft.  
\*Mesh size \_\_\_\_\_ Type \_\_\_\_\_  
• \_\_\_\_\_ inches from \_\_\_\_\_ to \_\_\_\_\_ ft.  
\*Mesh size \_\_\_\_\_ Type \_\_\_\_\_  
• \_\_\_\_\_ inches from \_\_\_\_\_ to \_\_\_\_\_ ft.  
\*Mesh size \_\_\_\_\_ Type \_\_\_\_\_  
\*Gravel pack  
• From \_\_\_\_\_ to \_\_\_\_\_ ft.  
• From \_\_\_\_\_ to \_\_\_\_\_ ft.  
\*Grout  
• From 0 to 50 ft., Type PRESSURE  
• From \_\_\_\_\_ to \_\_\_\_\_ ft., Type \_\_\_\_\_


2. WATER DATA \* Water temperature \_\_\_\_\_ OF  
\*Static water level (unpumped level-measured) 30 ft.  
\*Stabilized measured pumping water level 144 ft.  
\*Stabilized yield 15 gpm after 1 hours  
Natural Flow: Yes \_\_\_\_\_ No \_\_\_\_\_ flow rate \_\_\_\_\_ gpm  
Comment on quality \_\_\_\_\_  
3. WATER ZONES: From \_\_\_\_\_ To \_\_\_\_\_  
From \_\_\_\_\_ To \_\_\_\_\_ From \_\_\_\_\_ To \_\_\_\_\_  
From \_\_\_\_\_ To \_\_\_\_\_ From \_\_\_\_\_ To \_\_\_\_\_  
4. USE DATA:  
Type of use: Drinking  Livestock Watering \_\_\_\_\_  
Irrigation \_\_\_\_\_ Food processing \_\_\_\_\_ Household   
Manufacturing \_\_\_\_\_ Fire safety \_\_\_\_\_ Cleaning \_\_\_\_\_  
Recreation \_\_\_\_\_ Aesthetic \_\_\_\_\_ Cooling or heating \_\_\_\_\_  
Injection \_\_\_\_\_ Other \_\_\_\_\_  
\*Type of facility: Domestic  Public water supply \_\_\_\_\_  
Public institution \_\_\_\_\_ Farm \_\_\_\_\_ Industry \_\_\_\_\_  
Commercial \_\_\_\_\_ Other \_\_\_\_\_  
5. PUMP DATA: Type \_\_\_\_\_ \* Rated H.P. \_\_\_\_\_  
\* Intake depth \_\_\_\_\_ \* Capacity \_\_\_\_\_ at \_\_\_\_\_ head  
6. WELLHEAD: Type well seal \_\_\_\_\_  
Pressure tank \_\_\_\_\_ gal. Loc. \_\_\_\_\_  
Sample tap \_\_\_\_\_ Measurement port \_\_\_\_\_  
Well vent \_\_\_\_\_ Pressure relief valve \_\_\_\_\_  
Gate valve \_\_\_\_\_ Check valve (when required) \_\_\_\_\_  
Electrical disconnect switch on power supply \_\_\_\_\_  
7. DISINFECTION: Well disinfected \_\_\_\_\_ yes \_\_\_\_\_ no \_\_\_\_\_  
Date \_\_\_\_\_ Disinfectant used \_\_\_\_\_  
Amount \_\_\_\_\_ Hours used \_\_\_\_\_  
8. ABANDONMENT (where applicable) \* yes \_\_\_\_\_ no \_\_\_\_\_  
Casing pulled yes \_\_\_\_\_ no \_\_\_\_\_ not applicable \_\_\_\_\_  
Plugging grout From \_\_\_\_\_ to \_\_\_\_\_ material \_\_\_\_\_

Owner SUNSHINE HOMES

BWCA No. \_\_\_\_\_

9. State law requires submitting to the Virginia State Water Control Board information about groundwater and wells for every well made in the State intended for water, or any other non-exempt well. This information must be submitted whether the well is completed, on standby, or abandoned. Information required includes: an accurately and completely prepared water well completion report, full data from any aquifer pumping tests, drill cuttings taken at ten foot intervals (unless exemption is secured), the results of any chemical analyses, and copies of any geophysical logs. Quarterly pumpage and use reports are required from owners of public supply and industrial wells. County or State permits to drill may be required in some parts of the state. Some counties require submission of a water well completion report. The Virginia State Health Department requires a water well completion report for public supply wells.

10. DRILLERS LOG (use additional Sheets if necessary)			11. Drilling Time (Min.)	12. DIAGRAM OF WELL CONSTRUCTION (with dimensions)
DEPTH (feet)		TYPE OF ROCK OR SOIL		
From	To	(color, material, fossils, hardness, etc.)	(water, casing, cavities, broken, core, shot, etc.)	
0	70	Red Soil		Well 145 FT CASING 80 FT GROUT 50+ FT WATER TIGHT CAP
70	145	BROWN SHALE		

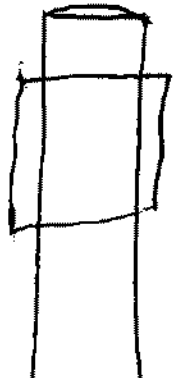

13. Well for dedicated? \_\_\_\_\_ Size \_\_\_\_\_ ft. X \_\_\_\_\_ ft., Well house? \_\_\_\_\_  
 Distance to nearest pollutant source \_\_\_\_\_ ft., Type \_\_\_\_\_  
 Distance to nearest property line \_\_\_\_\_ ft., Building \_\_\_\_\_ ft.

14. WATER SERVICE PIPE: Checked under \_\_\_\_\_ p.s.i. for \_\_\_\_\_ minutes. Pipe size \_\_\_\_\_ inches, Material \_\_\_\_\_  
 Installer \_\_\_\_\_  
 Date \_\_\_\_\_

15. I certify that the information contained herein is true and correct and that this well and/or system has been installed and constructed in accordance with the requirements for well construction as specified in compliance with appropriate county or independent city ordinances and the laws and rules of the Commonwealth of Virginia.

**State Water Control Board Regional Offices**

Valley Reg. Off.  
 116 North Main Street  
 P. O. Box 268  
 Bridgewater, Va. 22812  
 703-828-2595

Southwest Reg. Off.  
 408 East Main Street  
 P. O. Box 476  
 Abingdon, Va. 24210  
 703-628-5183

West Central Reg. Off.  
 Executive Park  
 5312 Peters Creek Road  
 Roanoke, Va. 24019  
 708-982-7432

Piedmont Reg. Off.  
 4010 West Broad Street  
 P. O. Box 6616  
 Richmond, Va. 23230  
 804-257-1006

Tidewater Reg. Off.  
 287 Pembroke Office Park  
 Suite 310 Pembroke No. 2  
 Va. Beach, Va. 23462  
 804-499-8742

Northern Virginia Reg. Off.  
 5515 Cherokee Avenue  
 Suite 404  
 Alexandria, Va. 22312  
 703-750-9111

Signature Jerry Carter (Seal) Date 12/19/01  
 (Well driller/authorized person)  
 License No. 0242207A