

Commonwealth of Virginia

Uniform Water Well Completion Report

Owner Patrick & Shelley Reilly
Address 360 Castlebury Court
Stafford Va. 22554
Phone 703-5443
Location Timber Ridge #15

Tax Map ID 25D-15
VDH Permit SW-94-130
VWCB Permit _____
VWCB ID _____
County Stafford
4-26-94 Dan Jansky
5-3-94 JJJ

Well Classification IIIA _____ IIIB IIIC _____ IV _____
* Well Data *

DJC

General Information

Drilling Method Air Rotary Date Completed 12/29/94
Depth to Bedrock 35 Yield 12 (GPM)
Static Water Level 40 Stabilized Water Level 120
Well Disinfected (Y or N) _____ Disinfectant Used _____

Total Depth of Well 200'
Length of Test Approx 1 Hr
Natural Flow (Rate) _____
Amount Used _____

Casing

From +1 To 57 From 40 To 160
Size 4" Material P.V.C. Size 4" Material P.V.C.
Weight/Schedule SDR 27 Weight/Schedule Sch 40

From 180 To 200
Size 4" Material P.V.C.
Weight/Schedule Sch 40

Gravel Pack

From _____ To _____ From _____ To _____ From _____ To _____

Hole size

10" from 0 to 57 ft. 6 1/8" from 57 to 200 ft. _____ " from _____ to _____ ft.

Grout

From 0 To 50' From _____ To _____ From _____ To _____
Bore Hole Size 10" Bore Hole Size _____ Bore Hole Size _____
Type Bentonite Type _____ Type _____
Method Pressure Grouting Method _____ Method _____

Water Zones or Screened Intervals

From 160 To 180 From 100 To 180 From _____ To _____
Mesh Size .020 Diam 4" P.V.C. Mesh Size _____ Diam _____ Mesh Size _____ Diam _____
From _____ To _____ From 170 To 171 From _____ To _____
Mesh Size _____ Diam _____ Mesh Size _____ Diam _____ Mesh Size _____ Diam _____

* Use Data *

Private Well: Domestic Agricultural _____ Industrial _____ Monitoring _____
Public Well: Community _____ Non Community _____

* Abandonment Information *

Bored or Dug Wells

Casing Removed, Y or N? _____
If Y, Depth to which casing was removed: _____
Depth and Type of Fill: _____
Source of Fill: _____
Bentonite Plugs: From _____ to _____ From _____ to _____

Wells other than Bored Wells

Casing removed, Y or N? _____
Depth to which casing was removed: _____
Applicable, depth(s), and type of gravel/sand fill: _____
Source of gravel or sand: _____
Cement: From _____ to _____ From _____ to _____

Method of permanently marking location: _____


Installed watertight top
Suggest setting pump @ approx. 140 ft.

You will encounter 4" casing @ approx 40'
Suggest keeping torque wrenches & centralizers out of 4" casing

Charles Beck, Jr. Enterprise Homes
Patrick & Shelby Kelly
Timber Ridge #15
 Stopped 24 above #691
 Drillers Log

W.V. LAB 11/11/95

Depth	Description of Formation or Sediment	Remarks
0	10	Red Clay
10	35	Brown Clay
35	57	Soft Brown Rock
57	100	Brown Rock
100	200	Dark Grey Rock

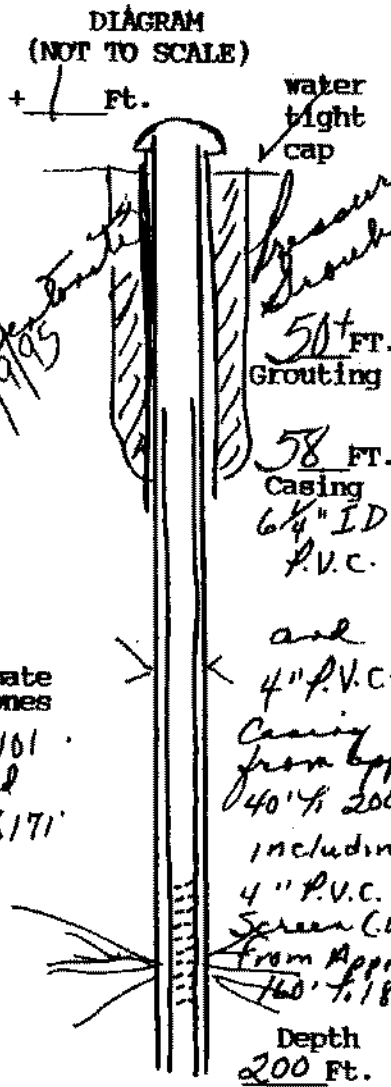

Approximate Water Zones
 100' to 101'
 and
 170' to 171'


(User additional Sheets if necessary)

I certify that the information contained here is true and that this well was installed and constructed in accordance with the permit and further that the well complies with all applicable state and local regulations, ordinances and laws.

Name JOHN L. DANIELSON, JR., INC.
 Address 4616 HOOD DRIVE
FREDERICKSBURG, VIRGINIA 22408
 Phone (703) 898-6025 / 898-9355
 Drillers Signature [Signature]
 Date 1/19/95 Representing JOHN L. DANIELSON, JR., INC.
 Virginia Contractors License Number CLASS A 2701 014084A H/H WWC

250.00

* DRAWING IS NOT TO SCALE.

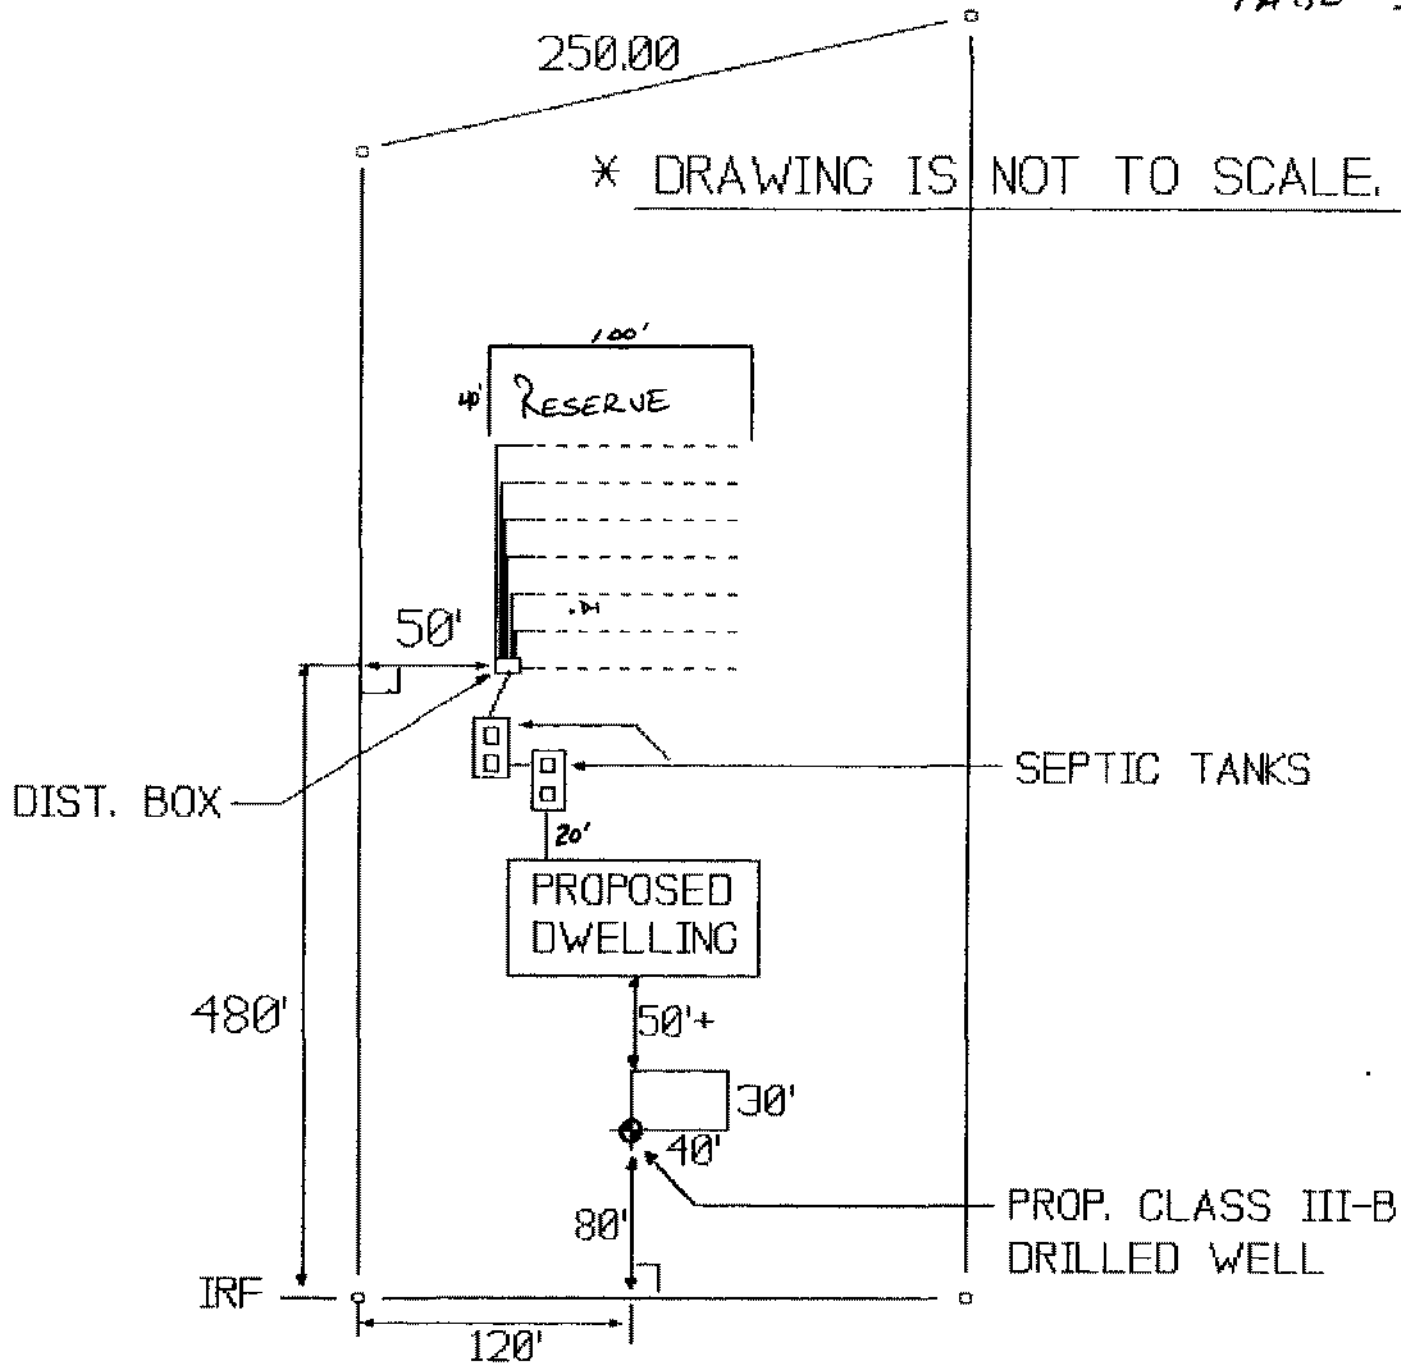

TIMBER RIDGE DRIVE TO RT. 17