

absolutely  
no 01.

Home Builders

Commonwealth of Virginia  
Uniform Water Well Completion Report

Owner Horris Home Builders / For Sale  
Address 700 Bay 1615  
Springfield, Va 22553  
Phone 582-6301  
Location Blake Farms Sect 3 Lot 35 (Marchant Drive)  
183A (#649 off 11)  
Well Classification IIIA IIIB IIIC IV

Tax Map ID 25C-3-35  
VDH Permit SWP-94-406  
VWCB Permit \_\_\_\_\_  
VWCB ID \_\_\_\_\_  
County Stafford  
10/11/94 Ashton B Wright

\* Well Data \*

General Information

Drilling Method Air Rotary  
Depth to Bedrock 90  
Static Water Level 40'  
Well Disinfected (Y or N) \_\_\_\_\_

Date Completed 12/20/94  
Yield 10 (GPM)  
Stabilized Water Level 80'  
Disinfectant Used \_\_\_\_\_

Total Depth of Well 200'  
Length of Test approx 1 Hr.  
Natural Flow (Rate) \_\_\_\_\_  
Amount Used \_\_\_\_\_

Casing

From 1 To 77  
Size 6 1/4" Material P.V.C.  
Weight/Schedule SDR 27

From 77 To 117  
Size 6 1/2" Material P.V.C.  
Weight/Schedule SDR 21

From \_\_\_\_\_ To \_\_\_\_\_  
Size \_\_\_\_\_ Material \_\_\_\_\_  
Weight/Schedule \_\_\_\_\_

Gravel Pack

From \_\_\_\_\_ To \_\_\_\_\_

From \_\_\_\_\_ To \_\_\_\_\_

From \_\_\_\_\_ To \_\_\_\_\_

Hole size

10" from 0 to 117 ft.

6 1/2" from \_\_\_\_\_ to \_\_\_\_\_ ft.

\_\_\_\_\_ " from \_\_\_\_\_ to \_\_\_\_\_ ft.

Grout

From 0 To 50+  
Bore Hole Size 10"  
Type Bentonite  
Method Pressure Grouting

From \_\_\_\_\_ To \_\_\_\_\_  
Bore Hole Size \_\_\_\_\_  
Type \_\_\_\_\_  
Method \_\_\_\_\_

From \_\_\_\_\_ To \_\_\_\_\_  
Bore Hole Size \_\_\_\_\_  
Type \_\_\_\_\_  
Method \_\_\_\_\_

Water Zones or Screened Intervals

From 120 To 121  
Mesh Size \_\_\_\_\_ Diam \_\_\_\_\_  
From 180 To 181  
Mesh Size \_\_\_\_\_ Diam \_\_\_\_\_

From \_\_\_\_\_ To \_\_\_\_\_  
Mesh Size \_\_\_\_\_ Diam \_\_\_\_\_  
From \_\_\_\_\_ To \_\_\_\_\_  
Mesh Size \_\_\_\_\_ Diam \_\_\_\_\_

From \_\_\_\_\_ To \_\_\_\_\_  
Mesh Size \_\_\_\_\_ Diam \_\_\_\_\_  
From \_\_\_\_\_ To \_\_\_\_\_  
Mesh Size \_\_\_\_\_ Diam \_\_\_\_\_

\* Use Data \*

Private Well: Domestic  Agricultural \_\_\_\_\_ Industrial \_\_\_\_\_ Monitoring \_\_\_\_\_  
Public Well: Community \_\_\_\_\_ Non Community \_\_\_\_\_

\* Abandonment Information \*

Bored or Dug Wells

Casing Removed, Y or N? \_\_\_\_\_  
If Y, Depth to which casing was removed: \_\_\_\_\_  
Depth and Type of Fill: \_\_\_\_\_  
Source of Fill \_\_\_\_\_  
Bentonite Plugs: From \_\_\_\_\_ to \_\_\_\_\_ From \_\_\_\_\_ to \_\_\_\_\_

Wells other than Bored Wells

Casing removed, Y or N? \_\_\_\_\_  
Depth to which casing was removed: \_\_\_\_\_  
Applicable, depth(s), and type of gravel/sand fill: \_\_\_\_\_  
Source of gravel or sand: \_\_\_\_\_  
Cement: From \_\_\_\_\_ to \_\_\_\_\_ From \_\_\_\_\_ to \_\_\_\_\_


Method of permanently marking location: \_\_\_\_\_  
 Installed watertight top  
Suggest setting pump @ approx. 100 ft.

WYLABDON

Horizon Home Builders  
Beake Farm # 35  
Stafford Co.  
#649

\* Drillers Log \*

Depth	Description of Formation or Sediment	Remarks
0 10	Red Clay	
10 90	Brown Clay	
90 117	Soft Brown Shale	
117 200	Light Grey Rock	

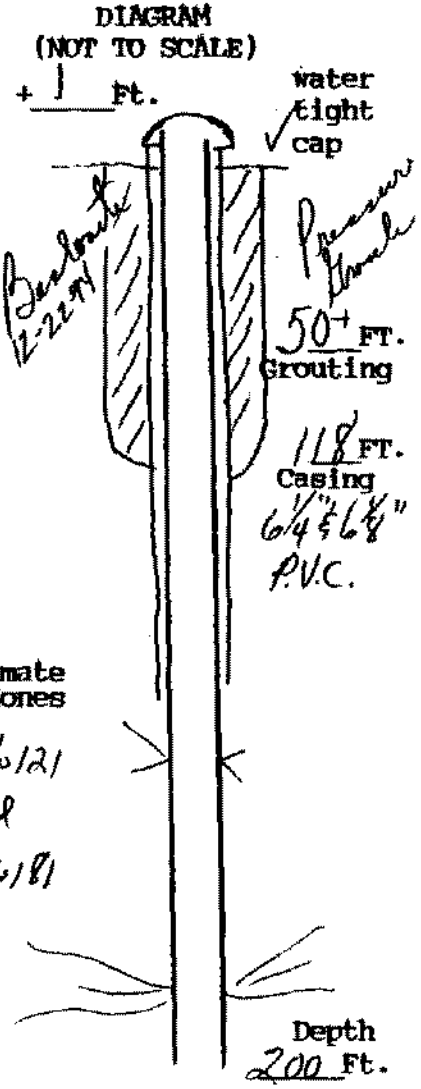

Approximate  
Water Zones  
120 to 121  
and  
180 to 181

(User additional Sheets if necessary)

I certify that the information contained here is true and that this well was installed and constructed in accordance with the permit and further that the well complies with all applicable state and local regulations, ordinances and laws.

Name JOHN L. DANIELSON, JR., INC.  
 Address 4616 HOOD DRIVE  
FREDERICKSBURG, VIRGINIA 22408  
 Phone (703) 898-6025 / 898-9355

Drillers Signature *John L. Danielson, Jr. Pres.*  
 Date 12/22/94 Representing JOHN L. DANIELSON, JR., INC.

Virginia Contractors License Number CLASS A 2701 014084A H/H WNC